

Tate
L 2000
9-5-80

MISSISSIPPI
BOARD OF WATER COMMISSIONERS
416 North State Street
Jackson, Mississippi 39201

WATER WELL DRILLERS LOG

9-5-1980 date well completed High Well Co. firm name Tate county well located

LANDOWNER: <u>Lo Arly Jones</u>	description of formations encountered	from	to
<u>Sensations, Ms.</u> (mailing address)	Red Clay	0	20
	Gravel	20	60
WELL LOCATION: sec. <u>12</u> T. <u>6</u> N. R. <u>8</u> E. <u>2</u> miles <u>S</u> of <u>Sensations</u> (distance) (direction) (nearest town)	White sand	60	145
WELL PURPOSE: <u>Home</u> (home, irrigation, municipal, industrial)			
WELL COMPLETION DATA: (1) diameter (inches) <u>4</u> (2) total depth (feet) <u>145</u> (3) static water level (feet) <u>80</u> below above top of ground. (4) casing <u>PVC</u> , <u>145</u> , (material) (depth) (size) If telescope see back. (5) screen <u>7</u> , <u>138</u> (length) (depth to top) <u>4"</u> , <u>gravel type</u> (size) (material) (6) pump <u>1/2</u> , <u>10</u> (HP) (yield gpm) <u>2500</u> (type power) (7) electric log <u>No</u> (yes or no) (organization running log) (8) how well bottom plugged <u>Cap</u>			

DRILLERS REMARKS:


DEPT. OF NATURAL RESOURCES
BUREAU OF LAND & WATER RESOURCES

SEP 29 1980

RECEIVED

If well telescopes please sketch and show depths.

GROUND LEVEL

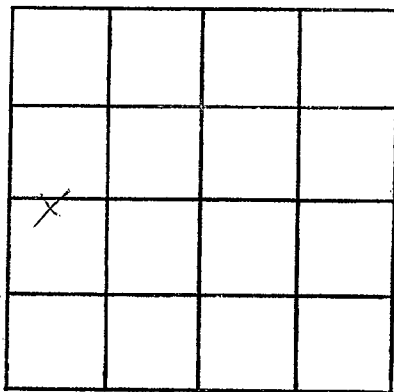

SECTION 12

Please indicate well location X.

ADDITIONAL INFORMATION

If more than one screen,
show locations of each on sketch.