

TATE  
L 2000  
6-3-80

MISSISSIPPI  
BOARD OF WATER COMMISSIONERS  
416 North State Street  
Jackson, Mississippi 39201

WATER WELL DRILLERS LOG

6-3 date well completed 19 80 firm name Mike Well Co. - Tate county well located

LANDOWNER:  
Tom Car  
Rt. 1, Senatobia  
(mailing address)

description of formations encountered	from	to
Clay	0	40
red sand	40	110
white sand	110	155

WELL LOCATION:  
sec. 7 T 6 N R 8 E  
4 miles S of Senatobia  
(distance) (direction) (nearest town)

WELL PURPOSE: Home  
(home, irrigation, municipal, industrial)

WELL COMPLETION DATA:  
(1) diameter (inches) 4 in  
(2) total depth (feet) 155  
(3) static water level (feet) 110 below top of ground.  
(4) casing Plastic 155 (material) (depth)  
(size) if telescope see back.  
(5) screen 7 ft 148 (length) (depth to top)  
4 in Gravel PVC (size) (material)  
(6) pump 1/2 10 (HP) (yield gpm)  
220 (type power)  
(7) electric log No (yes or no)  
(organization running log)  
(8) how well bottom plugged Cap

DRILLERS REMARKS:


DEPT. OF NATURAL RESOURCES  
BUREAU OF LAND & WATER RESOURCES

JUN 25 1980

RECEIVED

If well telescopes please sketch and show depths.

GROUND LEVEL

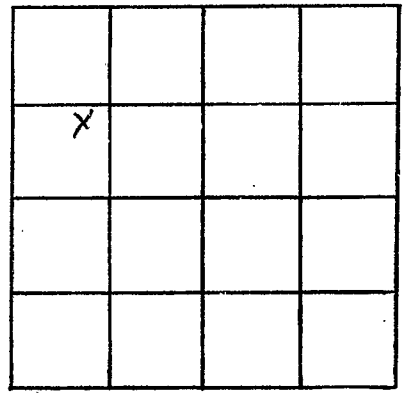

SECTION 7

Please indicate well location X.

ADDITIONAL INFORMATION

A series of horizontal lines for writing additional information, starting below the 'ADDITIONAL INFORMATION' header.

If more than one screen, show locations of each on sketch.