

MISSISSIPPI DEPARTMENT OF NATURAL RESOURCES

Bureau of Land and Water Resources

Southport Mall

P.O. Box 10631

Jackson, Mississippi 39209

WATER WELL DRILLERS LOG

TATE
L 2009
11-15-81

Tate

11-5 1981 date well completed HICKS WELL COMPANY RT. 1 - BOX 157E county well located


LANDOWNER: <i>Charles Richard Tate</i>	MISS. description of formations encountered	from	to
<i>Rt. 2</i>	<i>Red Clay</i>	<i>0</i>	<i>15</i>
<i>Senotobia, Mo.</i> (mailing address) <i>38668</i>	<i>Gravel</i>	<i>15</i>	<i>118</i>
WELL LOCATION: sec. <i>12-6</i> N R <i>8</i> E <i>2</i> miles SW of <i>Senotobia</i>	<i>Gravel + clay</i>	<i>118</i>	<i>125</i>
(distance) (direction) (nearest town)	<i>White Clay + Sand</i>	<i>125</i>	<i>140</i>
WELL PURPOSE: <i>Home</i> (home, irrigation, municipal, industrial)	<i>White Sand</i>	<i>140</i>	<i>170</i>
WELL COMPLETION DATA:			
(1) diameter (inches) <i>4</i>			
(2) total depth (feet) <i>170</i>			
(3) static water level (feet) <i>140</i> below above top of ground.			
(4) casing <i>PK</i> <i>170</i> (material) (depth)			
<i>—</i> (size) if telescope see back.			
(5) screen <i>12</i> <i>158</i> " (length) (depth to top)			
<i>4</i> <i>gravel + PK</i> (size) (material)			
(6) pump <i>1/2</i> <i>10</i> (HP) (yield gpm)			
<i>220V</i> (type power)			
(7) electric log <i>No</i> (yes or no)			
(organization running log)			
(8) how well bottom plugged <i>Cap</i>			

DRILLERS REMARKS:

DEPT. OF NATURAL RESOURCES
BUREAU OF LAND & WATER RESOURCES
NOV 30 1981
NOV 30 1981
RECEIVED

If well telescopes please sketch and show depths.

GROUND LEVEL

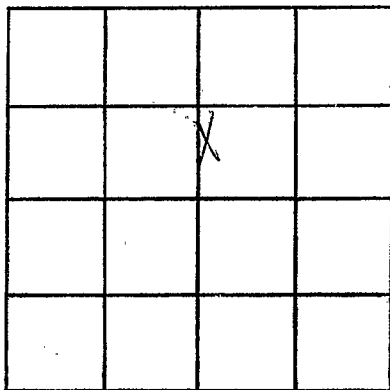

SECTION 12

Please indicate well location X.

ADDITIONAL INFORMATION

If more than one screen,
show locations of each on sketch.