

MISSISSIPPI DEPARTMENT OF NATURAL RESOURCES

Bureau of Land and Water Resources

Southport Mall

P.O. Box 10631

Jackson, Mississippi 39209

WATER WELL DRILLERS LOG

HICKS WELL COMPANY

Date
5/7/82

5/7 1982 RT 1 BOX 157  
 date well completed Senatobia MISS firm name Tate county well located

LANDOWNER: Willie Savage  
 P.O. Box 794  
 Senatobia, Miss. 38668  
 (mailing address)

WELL LOCATION:  
 sec. 1 T 6 N R 8 E  
 S W  
 2 miles SW of Senatobia  
 (distance) (direction) (nearest town)

description of formations encountered	from	to
Red Clay	0	20
Red Sand	20	45
Red Sand & Gravel	45	110
White Sand	110	155

WELL PURPOSE: home  
 (home, irrigation, municipal, industrial)

WELL COMPLETION DATA:

(1) diameter (inches) 4

(2) total depth (feet) 155

(3) static water level (feet) 120 below above top of ground.

(4) casing PVC 155 (material) (depth)  
 (size) If telescope see back.

(5) screen 10 145 (length) (depth to top)

0.10X6XXX PVC (size) (material)

(6) pump 1/2 10 (HP) (yield gpm)  
 220v (type power)

(7) electric log no (yes or no)  
 (organization running log)

(8) how well bottom plugged cap


DRILLERS REMARKS:

DEPT. OF NATURAL RESOURCES  
 BUREAU OF LAND & WATER RESOURCES

JUN 14 1992  
 RECEIVED

If well telescopes please sketch and show depths.

GROUND LEVEL

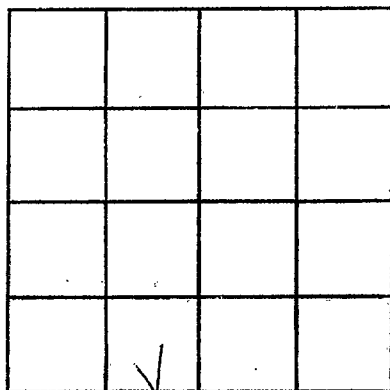

SECTION 1

Please indicate well location X.

ADDITIONAL INFORMATION

If more than one screen,  
show locations of each on sketch.