

MISSISSIPPI DEPARTMENT OF NATURAL RESOURCES

Bureau of Land and Water Resources

Southport Mall

P.O. Box 10631

Jackson, Mississippi 39209

WATER WELL DRILLERS LOG

HICKS WELL CO.

Rt. 1 Box 157

Senatobia, MS 38668

Tate

Date  
 2 2011

8-17-1982  
 date well completed

county well located

LANDOWNER: <u>M. P. Moore</u>	description of formations encountered	from	to
<u>Senatobia, Miss 38668</u> (mailing address)	<u>Red Sand</u>	<u>0</u>	<u>20</u>
	<u>P. - Gravel</u>	<u>20</u>	<u>65</u>
	<u>Gravel</u>	<u>65</u>	<u>110</u>
	<u>White Sand</u>	<u>110</u>	<u>145</u>
<b>WELL LOCATION:</b> sec <u>1</u> T <u>6</u> N R <u>8</u> E <u>2</u> miles <u>SW</u> of <u>Senatobia</u> (distance) (direction) (nearest town)			
<b>WELL PURPOSE:</b> <u>Home</u> (home, irrigation, municipal, industrial)			
<b>WELL COMPLETION DATA:</b>			
(1) diameter (inches) <u>4</u>			
(2) total depth (feet) <u>145</u>			
(3) static water level (feet) <u>100</u> <sup>below</sup> above top of ground.			
(4) casing <u>PVC</u> , <u>145</u> (material) (depth) <u>4</u> (size) if telescope see back.			
(5) screen <u>10</u> , <u>135</u> (length) (depth to top) <u>013</u> , <u>PVC</u> (size) (material)			
(6) pump <u>1/2</u> , <u>10</u> (HP) (yield gpm) <u>220V</u> (type power)			
(7) electric log <u>No</u> (yes or no)			
(organization running log)			
(8) how well bottom plugged <u>Cap</u>			
<b>DRILLERS REMARKS:</b>			


DEPT. OF NATURAL RESOURCES  
 BUREAU OF LAND & WATER RESOURCES

AUG 27 1982

RECEIVED

If well telescopes please sketch and show depths.

GROUND LEVEL

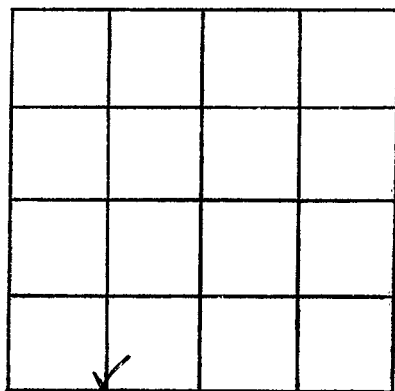

SECTION 1

Please indicate well location X.

ADDITIONAL INFORMATION

If more than one screen, show locations of each on sketch.