

MISSISSIPPI DEPARTMENT OF NATURAL RESOURCES

Bureau of Land and Water Resources

Southport Mall

P.O. Box 10631

Jackson, Mississippi 39209

WATER WELL DRILLERS LOG

Date  
 L 2012

4-30-83 19 date well completed Bob Smith firm name Jate county well located

LANDOWNER:  
Richard Ladd  
Senatobia, MS  
 (mailing address)

description of formations encountered	from	to
top soil	0	5
red clay	5	19
red wh. clay	19	136
gravel	136	150
sand	150	170

WELL LOCATION:  
 sec 25 T-6 N R-8 E  
 (S) (W)  
2 miles W. of Senatobia  
 (distance) (direction) (nearest town)

WELL PURPOSE:  
 (home) irrigation, municipal, industrial

WELL COMPLETION DATA:

(1) diameter (inches) 4"

(2) total depth (feet) 170'

(3) static water level (feet) 80'  below  above top of ground.

(4) casing plastic 170'  
 (material) (depth)

       If telescope see back.  
 (size)

(5) screen 10 , 160'  
 (length) (depth to top)

4" , plastic  
 (size) (material)

(6) pump 1/2 10  
 (HP) (yield gpm)

elec.  
 (type power)

(7) electric log (yes of no)

        
 (organization running log)

(8) how well bottom plugged Cap

DEPT. OF NATURAL RESOURCES  
 BUREAU OF LAND & WATER RESOURCES


OCT 12 1982

RECEIVED

DRILLERS REMARKS:

If well telescopes please sketch and show depths.

GROUND LEVEL

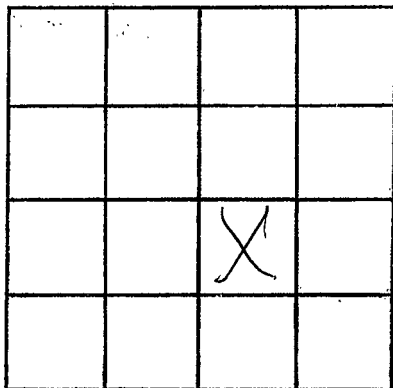

SECTION \_\_\_\_\_

Please indicate well location X.

ADDITIONAL INFORMATION

If more than one screen,  
show locations of each on sketch.