

MISSISSIPPI DEPARTMENT OF NATURAL RESOURCES

Bureau of Land and Water Resources

Southport Mall

P.O. Box 10631

Jackson, Mississippi 39209

WATER WELL DRILLERS LOG

Date
 L 2013

1-25 1983
 date well completed

HICKS WELL CO
 Dr. 1 Box 157
 Senatobia, Miss 38668
 firm name

Tate
 county well located

LANDOWNER: Willie Hilder
Rt. 2 Box 55B
Senatobia, Mo. 38668
 (mailing address)

description of formations encountered	from	to
Red Clay	0	20
Red Sand	20	50
Red Sand + Gravel	50	110
White Clay + Sand	110	130
White Sand	130	155

WELL LOCATION:
 sec. 12 T. 6 N. R. 8 E.
2 1/2 miles SW of Senatobia
 (distance) (direction) (nearest town)

WELL PURPOSE: Home
 (home, irrigation, municipal, industrial)

- WELL COMPLETION DATA:
- (1) diameter (inches) 4
 - (2) total depth (feet) 155
 - (3) static water level (feet) 120 below above top of ground.
 - (4) casing PVC 155
 (material) (depth)
4"
 (size) If telescope see back.
 - (5) screen 10' 145'
 (length) (depth to top)
1/3" PVC
 (size) (material)
 - (6) pump 1/2 10
 (HP) (yield gpm)
220V
 (type power)
 - (7) electric log No
 (yes or no)
 (organization running log)
 - (8) how well bottom plugged Cup

DRILLERS REMARKS:


DEPT. OF NATURAL RESOURCES
 BUREAU OF LAND & WATER RESOURCES

FEB 22 1983

RECEIVED

If well telescopes please sketch and show depths.

GROUND LEVEL

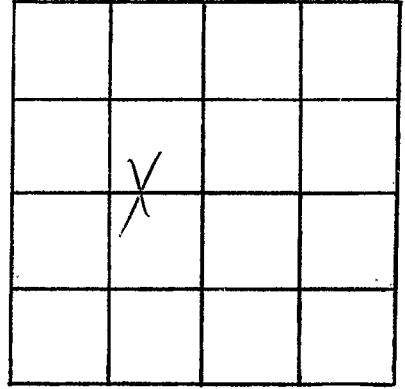

SECTION 12

Please indicate well location X.

ADDITIONAL INFORMATION

If more than one screen,
show locations of each on sketch.