

MISSISSIPPI DEPARTMENT OF NATURAL RESOURCES

Bureau of Land and Water Resources

Southport Mall

P.O. Box 10631

Jackson, Mississippi 39209

WATER WELL DRILLERS LOG

Date
 L 2014

5-31-83 date well completed
 HICKS WELL CO. name of contractor
 Senatobia, MS name of town
 Tate county well located

LANDOWNER: <u>Carnest Neuman</u>	description of fomations encountered	from	to
<u>Senatobia, Miss. 38668</u> (mailing address)			
	<u>Red Clay</u>	<u>0</u>	<u>20</u>
	<u>Red Sand</u>	<u>20</u>	<u>35</u>
	<u>Gravel</u>	<u>35</u>	<u>75</u>
	<u>White Sand + Clay</u>	<u>75</u>	<u>125</u>
	<u>White Sand</u>	<u>125</u>	<u>155</u>

WELL LOCATION:
 sec. 12 T. 6 N. R. 8 E.
2 miles SW of Senatobia
 (distance) (direction) (nearest town)

WELL PURPOSE: Home
 (home, irrigation, municipal, industrial)

WELL COMPLETION DATA:

- (1) diameter (inches) 4
- (2) total depth (feet) 155
- (3) static water level (feet) 80 ^{below} above top of ground.
- (4) casing PVC, 155,
 (material) (depth)
4"
 (size) if telescope see back.
- (5) screen 15', 140
 (length) (depth to top)
1/8", PVC
 (size) (material)
- (6) pump 1/2, 10
 (HP) (yield gpm)
220V
 (type power)
- (7) electric log No
 (yes or no)
 (organization running log)
- (8) how well bottom plugged Cap

DRILLERS REMARKS:


DEPT. OF NATURAL RESOURCES
 BUREAU OF LAND & WATER RESOURCES

JUN 27 1983

RECEIVED

If well telescopes please sketch and show depths.

GROUND LEVEL

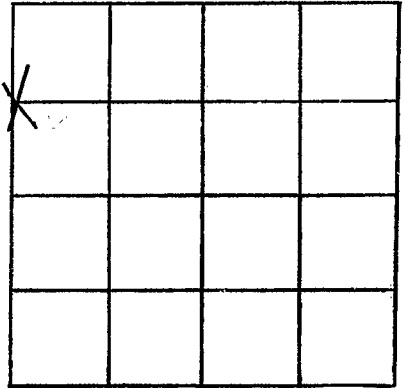

SECTION 12

Please indicate well location X.

ADDITIONAL INFORMATION

If more than one screen,
show locations of each on sketch.