

MISSISSIPPI DEPARTMENT OF NATURAL RESOURCES

Bureau of Land and Water Resources

Southport Mall

P.O. Box 10631

Jackson, Mississippi 39209

WATER WELL DRILLERS LOG

Tate
L 2015
5-10-85

HICKS WELL COMPANY

Tate

5-10-1985
date well completed

Rt. 1 firm name/

county well located

SENATORIA, MISS.

LANDOWNER: Willie J. Reed

description of formations encountered

from to

Senatoria MS 38668
(mailing address)

Red Clay	0	10
Red Sand	10	30
White Sand & Gravel	30	80
White Sand	80	170


WELL LOCATION:

sec. 1 T 6 N R 8 E
S SW W
4 miles South of Senatoria
(distance) (direction) (nearest town)

WELL PURPOSE: Home
(home, irrigation, municipal, industrial)

WELL COMPLETION DATA:

- (1) diameter (inches) 4"
- (2) total depth (feet) 170
- (3) static water level (feet) 80' below top of ground.
- (4) casing PVC, 160' (depth), 4" (size) if telescope see back.
- (5) screen 10' (length), 160' (depth to top), 10/10 (size), PVC (material)
- (6) pump 1/2 (HP), 10 (yield gpm), 220 V (type power)
- (7) electric log NO (yes or no)
(organization running log)
- (8) how well bottom plugged cap

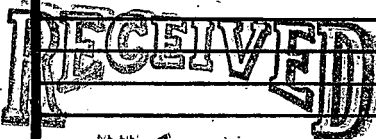


JUL 1 - 1985

DRILLERS REMARKS:

Department of Natural Resources
Bureau of Land & Water Resources

If well telescopes please sketch and show depths.

GROUND LEVEL

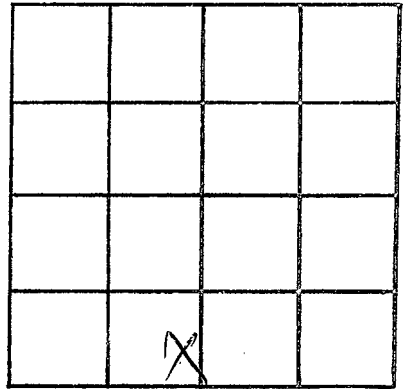

SECTION 1

Please indicate well location X.

ADDITIONAL INFORMATION

If more than one screen,
show locations of each on sketch.