

MISSISSIPPI DEPARTMENT OF NATURAL RESOURCES

Bureau of Land and Water Resources

Southport Mall

P.O. Box 10631

Jackson, Mississippi 39209

WATER WELL DRILLERS LOG

HICKS WELL COMPANY

TATE
Laurel

9-27 1985 date well completed RT. 1 - BOX 157 firm name SENATORIA, MISS. county well located

LANDOWNER: Jimmie Jones

description of formations encountered

from to

Senatoria, MS 38668 (mailing address)

Red clay 0 10

Limestone + red sand 10 30

WELL LOCATION:

sec. 12 T. 6 N. R. 8 E S W
3 miles S of Senatoria (distance) (direction) (nearest town)

Limestone 30 95

White clay 95 110

WELL PURPOSE: Home (home, irrigation, municipal, industrial)

White sand 110 140

WELL COMPLETION DATA:

(1) diameter (inches) 4"
(2) total depth (feet) 140'
(3) static water level (feet) 120' below above top of ground.

(4) casing PVC, 130' (material) (depth)
4" (size) if telescope see back.

(5) screen 10' 130' (length) (depth to top)

.03 PVC (size) (material)

(6) pump 1/2 10 (HP) (yield gpm)


220V (type power)

(7) electric log NO (yes or no)

(organization running log)

(8) how well bottom plugged Cap


DRILLERS REMARKS:

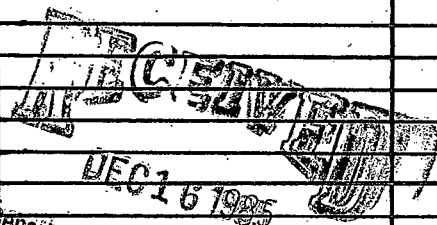

Department of Natural Resources
Bureau of Land & Water Resources

If well telescopes please sketch and show depths.

GROUND LEVEL

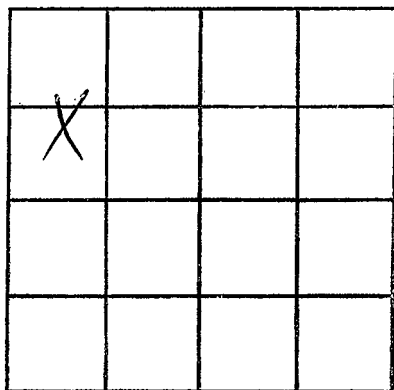

SECTION 12

Please indicate well location X.

ADDITIONAL INFORMATION

If more than one screen,
show locations of each on sketch.