

MISSISSIPPI DEPARTMENT OF NATURAL RESOURCES
 Bureau of Land and Water Resources
 Southport Mall
 P.O. Box 10631
 Jackson, Mississippi 39209
WATER WELL DRILLERS LOG

TATE
L 2018

11-7 1985 **HICKS WELL COMPANY** Yate
 date well completed RT. 1 - BOX 157E county well located

LANDOWNER: Berman Jones SENATOBIA MISS.
R# 1
Senatobia MS 38668
 (mailing address)

WELL LOCATION:
 sec. L T 6 N R. P E
S W
3 miles S of Senatobia
 (distance) (direction) (nearest town)

WELL PURPOSE: Home
 (home, irrigation, municipal, industrial)

WELL COMPLETION DATA:

(1) diameter (inches) 4"

(2) total depth (feet) 170'

(3) static water level (feet) 80' below above top of ground.

(4) casing PVC, 150',
 (material) (depth)
4"
 (size) If telescope see back.

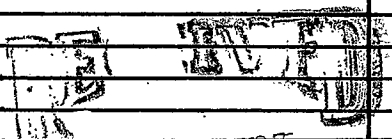
(5) screen 20', 150'
 (length) (depth to top)
1/2, PVC
 (size) (material)

(6) pump 1/2, 10
 (HP) (yield gpm)
2200
 (type power)

(7) electric log NO
 (yes or no)
 (organization running log)

(8) how well bottom plugged Cap

description of formations encountered	from	to
<u>Red clay</u>	<u>0</u>	<u>10</u>
<u>Red sand</u>	<u>10</u>	<u>30</u>
<u>Sand</u>	<u>30</u>	<u>90</u>
<u>White clay</u>	<u>90</u>	<u>120</u>
<u>White sand</u>	<u>120</u>	<u>170</u>

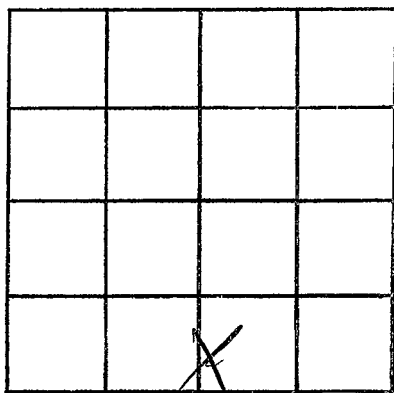

 DEC 16 1985

DRILLERS REMARKS:

DEPARTMENT OF NATURAL RESOURCES
 BUREAU OF LAND AND WATER RESOURCES
 JACKSON, MISSISSIPPI 39209

If well telescopes please sketch and show depths.

GROUND LEVEL



SECTION 1

Please indicate well location X.

ADDITIONAL INFORMATION

If more than one screen, show locations of each on sketch.