

# MISSISSIPPI DEPARTMENT OF NATURAL RESOURCES

Bureau of Land and Water Resources

P.O. Box 10631

Jackson, Mississippi 39209

## WATER WELL DRILLERS LOG

COUNTY WELL LOCATED <b>Tate</b>	
WELL NUMBER <b>L</b>	CODED
DATE WELL COMPLETED <b>2-3-87</b>	

PERMIT NUMBER
NAME OF DRILLING FIRM <b>HICKS WELL COMPANY</b>
RT. 1 - BOX 157

NAME & MAILING ADDRESS OF LANDOWNER <b>Senarobia, Miss</b> <b>Herman Toney</b> <b>LRL Rd.</b> <b>Senarobia, MS 39669</b>		
WELL LOCATION: SEC	TOWNSHIP	RANGE
<b>12</b>	<b>6</b>	<b>N S E W</b>
DISTANCE	DIRECTION	NEAREST TOWN
<b>4</b> Miles	<b>SW</b> of	<b>Senarobia</b>
OTHER LANDMARK		
WELL PURPOSE <input checked="" type="checkbox"/> Home Irrigation, Municipal, Industrial, Fish Pond, etc.		

<b>PUMP DATA</b>		
PUMP TYPE (Circle One): <input checked="" type="checkbox"/> Submersible, <input type="checkbox"/> Turbine, <input type="checkbox"/> Jet <input type="checkbox"/> Flowing Well, Other (Describe) _____		
POWER TYPE (Circle One): <input checked="" type="checkbox"/> Electric, <input type="checkbox"/> Tractor, <input type="checkbox"/> Diesel, <input type="checkbox"/> Gasoline, <input type="checkbox"/> Butane, Other (Describe) _____		
Pump Capacity (GPM)	No. of Stages	Setting Depth
<b>10</b>		<b>120</b> FT.
PUMP TEST		
Well yielded _____ GPM with a drawdown of _____ ft. after _____ hours of pumping		

<b>WELL DATA</b>		
Well Depth	Casing Diameter (In.)	Casing Length (Ft.)
<b>160'</b>	<b>4"</b>	<b>150'</b>
Type of Casing	Hole Depth	Depth to Static Water Level
<b>Pvc</b>	<b>160'</b>	<b>100'</b>
TYPE OF COMPLETION: (Circle One or More): Gravel Packed, Underreamed, Telescoped, Natural Development, Open Hole, Other (Describe) <b>Cap/Pvc</b>		
Top of Lap Pipe or Reduction in Casing		
FEET	IF TELESCOPED OR MORE THAN ONE SCREEN: USE BACK PAGE	

<b>LOG DATA</b>	
TYPE OF LOG RUN (Circle One): <input type="checkbox"/> No Log Run, <input type="checkbox"/> Electric, <input type="checkbox"/> Gamma Ray, <input type="checkbox"/> Density, <input type="checkbox"/> Sonic, <input type="checkbox"/> Neutron, Other (Describe) _____	
Name of Organization Running Log	

<b>SCREEN DATA</b>		
Diameter - Inches	Length - Feet	Slot Size - Inches
<b>4"</b>	<b>10'</b>	<b>.013</b>
Screen Type	Depth to Bottom - Feet	
<b>Pvc</b>	<b>160'</b>	

<b>GEOLOGIC DATA (Office Use Only)</b>			
Surface Elev.	Geologic Unit	Unit Thickness	Depth to Top
Subs. SWL	Date	Analysis	Aquifer Test

Driller's Remarks

DESCRIPTION OF FORMATIONS ENCOUNTERED	FROM	TO
<b>Red clay</b>	<b>0</b>	<b>10</b>
<b>Gravel</b>	<b>10</b>	<b>95</b>
<b>White Sand</b>	<b>95</b>	<b>160</b>

INFORMATION (Continued)

RECEIVED


APR 29 1987

Department of Natural Resources  
Bureau of Land & Water Resources

IF MORE SPACE IS NEEDED, USE BACK

If well telescopes please sketch and show depths.

GROUND LEVEL

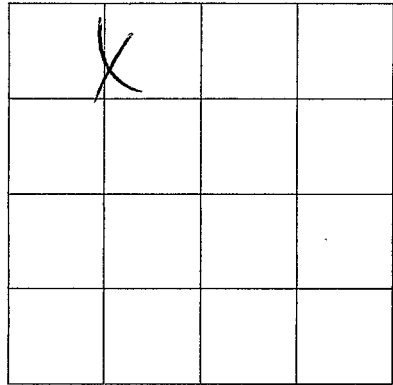

SECTION 12

Please indicate well location X.

ADDITIONAL INFORMATION

If more than one screen,  
show location of each on sketch.