

MISSISSIPPI DEPARTMENT OF NATURAL RESOURCES

Bureau of Land and Water Resources

COUNTY WELL LOCATED TATE	
WELL NUMBER L	CODED
DATE WELL COMPLETED 1-30-90	

HICKS WELL CO.	
NAME OF DRILLING FIRM RT 1 BOX 157	
SENATOBIA, MS 38668	

P.O. Box 10631
Jackson, Mississippi 39209
WATER WELL DRILLERS LOG

NAME & MAILING ADDRESS OF LANDOWNER TOM PARROT		
SENATOBIA,		
MS.		
WELL LOCATION: SEC	TOWNSHIP	RANGE
24	6 N	8 E
DISTANCE	DIRECTION	NEAREST TOWN
2 Miles	N/E	Senatobia
OTHER LANDMARK shelby wood sub div		
WELL PURPOSE (Home, Irrigation, Municipal, Industrial, Fish Pond, etc.)		

PUMP DATA		
PUMP TYPE (Circle One): <input checked="" type="radio"/> Submersible Turbine, Jet Flowing Well, Other (Describe) _____		
POWER TYPE (Circle One): <input checked="" type="radio"/> Electric, Tractor, Diesel, Gasoline, Butane, Other (Describe) _____ H/P 1/2		
Pump Capacity (GPM)	No. of Stages	Setting Depth
10	9	100 FT.
PUMP TEST		
Well yielded _____ GPM with a drawdown of _____ ft. after _____ hours of pumping		

WELL DATA		
Well Depth	Casing Diameter (In.)	Casing Length (Ft.)
120	4"	110
Type of Casing	Hole Depth	Depth to Static Water Level
PVC	120	80
TYPE OF COMPLETION: (Circle One or More): <input checked="" type="checkbox"/> Gravel Packed Underreamed, Telescoped, Natural Development, Open Hole, Other		
Top of Lap Pipe or Reduction in Casing		
FEET	IF TELESCOPED OR MORE THAN ONE SCREEN: USE BACK PAGE	

LOG DATA	
TYPE OF LOG RUN (Circle One): No Log Run, Electric, Gamma Ray, Density, Sonic, Neutron, Other (Describe) _____	
Name of Organization Running Log	

SCREEN DATA		
Diameter - Inches	Length - Feet	Slot Size - Inches
4"	10'	0.13
Screen Type	Depth to Bottom - Feet	
PVC	10	


GEOLOGIC DATA (Office Use Only)			
Surface Elev.	Geologic Unit	Unit Thickness	Depth to Top
Subs. SWL	Date	Analysis	Aquifer Test
Driller's Remarks			

DESCRIPTION OF FORMATIONS ENCOUNTERED	FROM	TO	FORMATIONS (Continued)	FROM	TO
RC	0	20	RECEIVED FEB 16 1990 Department of Natural Resources Bureau of Land & Water Resources		
RC+S	20	60			
CBV-SAND	60	90			
WS	90	120			

IF MORE SPACE IS NEEDED, USE BACK

If well telescopes please
sketch and show depths.

GROUND LEVEL

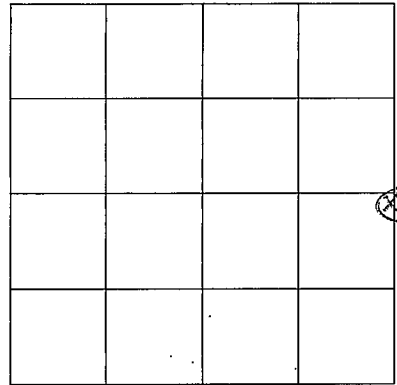

SECTION _____

Please indicate well location X.

ADDITIONAL INFORMATION

If more than one screen,
show location of each on sketch.