

MISSISSIPPI DEPARTMENT OF NATURAL RESOURCES

Bureau of Land and Water Resources

| | |
|--------------------------------------|-------|
| COUNTY WELL LOCATED TATE | |
| WELL NUMBER L | CODED |
| DATE WELL COMPLETED 2-7-90 | |

| | |
|---|--|
| HICKS WELL CO. | |
| PERMIT NUMBER RT. 1 BOX 157 | |
| NAME OF DRILLING FIRM SENATOBIA, MS 38668 | |

P.O. Box 10631
Jackson, Mississippi 39209
WATER WELL DRILLERS LOG

| | | |
|--|----------|----------|
| NAME & MAILING ADDRESS OF LANDOWNER Albert Wingo | | |
| RT. 3 | | |
| Senatobia, MS | | |
| WELL LOCATION: SEC | TOWNSHIP | RANGE |
| 29 | 6 | 8 |
| DISTANCE DIRECTION NEAREST TOWN 6 Miles W of Senatobia | | |
| OTHER LANDMARK (Crockett comm) | | |
| WELL PURPOSE: Home, Irrigation, Municipal, Industrial, Fish Pond, etc. | | |

| | | |
|---|----------------------------|---------------------------------|
| PUMP DATA | | |
| PUMP TYPE (Circle One): <u>Submersible</u> Turbine, Jet, Flowing Well, Other (Describe) _____ | | |
| POWER TYPE (Circle One): <u>Electric</u> Tractor, Diesel, Gasoline, Butane, Other (Describe) _____ H/P 3/4 | | |
| Pump Capacity (GPM) 10 | No. of Stages 12 | Setting Depth 140 FT. |
| PUMP TEST Well yielded _____ GPM with a drawdown of _____ ft. after _____ hours of pumping | | |

| | | |
|---|------------------------------------|---|
| WELL DATA | | |
| Well Depth 220 | Casing Diameter (In.) 4" | Casing Length (Fl.) 205 |
| Type of Casing PVC | Hole Depth 220 | Depth to Static Water Level 140 |
| TYPE OF COMPLETION: (Circle One or More): <u>Gravel Packed</u> Underreamed, Telescoped, Natural Development, Open Hole, Other (Describe) _____ | | |
| Top of Lap Pipe or Reduction in Casing FEET IF TELESCOPED OR MORE THAN ONE SCREEN: USE BACK PAGE | | |

| | |
|--|--|
| LOG DATA | |
| TYPE OF LOG RUN (Circle One): No Log Run, Electric, Gamma Ray, Density, Sonic, Neutron, Other (Describe) _____ | |
| Name of Organization Running Log | |

| | | |
|--------------------------------|-------------------------------------|----------------------------------|
| SCREEN DATA | | |
| Diameter - Inches 4" | Length - Feet 15' | Slot Size - Inches 013 |
| Screen Type PVC | Depth to Bottom - Feet 15 | |


| | | | |
|---------------------------------|---------------|----------------|--------------|
| GEOLOGIC DATA (Office Use Only) | | | |
| Surface Elev. | Geologic Unit | Unit Thickness | Depth to Top |
| Subs. SWL | Date | Analysis | Aquifer Test |
| Driller's Remarks | | | |

| DESCRIPTION OF FORMATIONS ENCOUNTERED | FROM | TO | FORMATIONS (Continued) | FROM | TO |
|---------------------------------------|------------|------------|--|------|----|
| RC - | 0 | 15 | RECEIVED FEB 16 1990 Department of Natural Resources Bureau of Land & Water Resources | | |
| RC & S | 15 | 45 | | | |
| RC & S | 45 | 100 | | | |
| 018Y | 100 | 180 | | | |
| WS | 180 | 220 | | | |
| | | | | | |
| | | | | | |
IF MORE SPACE IS NEEDED, USE BACK

If well telescopes please sketch and show depths.

GROUND LEVEL

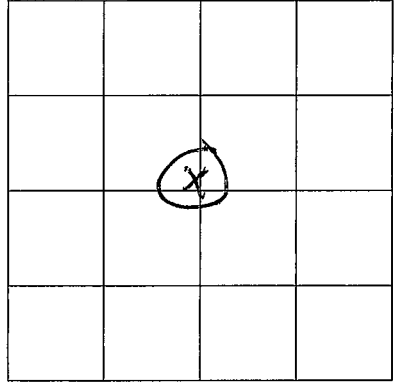

SECTION _____

Please indicate well location X.

ADDITIONAL INFORMATION

If more than one screen, show location of each on sketch.