

MISSISSIPPI DEPARTMENT OF ENVIRONMENTAL QUALITY
Bureau of Land and Water Resources

P. O. Box 10631
Jackson, MS 39289-0631
WATER WELL DRILLERS LOG

COUNTY WELL LOCATED TATE	
WELL NUMBER L	CODED
DATE WELL COMPLETED 2033 9-28-92	

PERMIT NUMBER HICKS WELL CO.
NAME OF DRILLING FIRM RT. 1 BOX 157 SENATOBIA, MS 38668

NAME & MAILING ADDRESS OF LANDOWNER Johnnie R Holt Pro. 92 Senatobia, MS		
WELL LOCATION: SEC	TOWNSHIP	RANGE
12	6	8
DISTANCE	DIRECTION	NEAREST TOWN
5 Miles	S	of Senatobia
OTHER LANDMARK		
WELL PURPOSE (Home) Irrigation, Municipal, Industrial, Fish Pond, etc.		

PUMP DATA		
PUMP TYPE (Circle One): <input checked="" type="radio"/> Submersible Turbine, Jet, Flowing Well, Other (Describe) _____		
POWER TYPE (Circle One): <input checked="" type="radio"/> Electric Tractor, Diesel, Gasoline, Butane, Other (Describe) _____ H/P <input checked="" type="checkbox"/>		
Pump Capacity (GPM) 10	No. of Stages 9	Setting Depth 120 FT.
PUMP TEST		
Well yielded _____ GPM with a drawdown of _____ ft. after _____ hours of pumping		

WELL DATA		
Well Depth 160	Casing Diameter (In.) 4"	Casing Length (Ft.) 150
Type of Casing PVC	Hole Depth 160	Depth to Static Water Level 100
TYPE OF COMPLETION: (Circle One or More): <input checked="" type="checkbox"/> Gravel Packed, Underreamed, Telescoped, Natural Development, Open Hole, Other		
Top of Lap Pipe or Reduction in Casing FEET IF TELESCOPED OR MORE THAN ONE SCREEN: USE BACK PAGE		

LOG DATA	
TYPE OF LOG RUN (Circle One): No Log Run, Electric, Gamma Ray, Density, Sonic, Neutron, Other (Describe) _____	
Name of Organization Running Log	

SCREEN DATA		
Diameter - Inches 4"	Length - Feet 10'	Slot Size - Inches 013
Screen Type PVC	Depth to Bottom - Feet 10'	

GEOLOGIC DATA (Office Use Only)			
Surface Elev.	Geologic Unit	Unit Thickness	Depth to Top
Subs. SWL	Date	Analysis	Aquifer Test
Driller's Remarks			

DESCRIPTION OF FORMATIONS ENCOUNTERED	FROM	TO	FORMATIONS (Continued)	FROM	TO
R/B	0	20			
CLAY	20	60			
CLAY	60	120			
W/S	120	160			


RECEIVED
OCT 23 1992

Dept. of Environmental Quality
Bureau of Land & Water Resources

IF MORE SPACE IS NEEDED, USE BACK

If well telescopes please sketch and show depths.

GROUND LEVEL

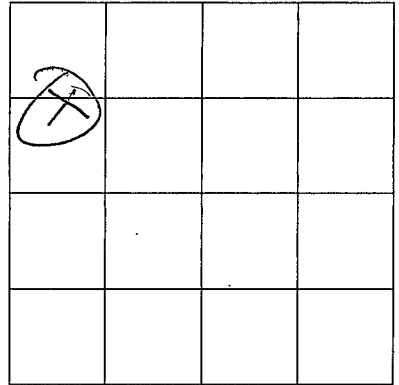

SECTION _____

Please indicate well location X.

ADDITIONAL INFORMATION

Horizontal lines for recording additional information.

If more than one screen, show location of each on sketch.