

MISSISSIPPI DEPARTMENT OF ENVIRONMENTAL QUALITY
Bureau of Land and Water Resources

P. O. Box 10631
Jackson, MS 39289-0631

WATER WELL DRILLERS LOG

COUNTY WELL LOCATED <i>TATE</i>	
WELL NUMBER <i>L</i>	CODED
<i>2037</i>	
DATE WELL COMPLETED <i>7-30-93</i>	

PERMIT NUMBER HICKS WELL CO.
NAME OF DRILLING FIRM <i>RT. 1 BOX 157</i> <i>SENATOBIA, MS 38668</i>

NAME & MAILING ADDRESS OF LANDOWNER <i>Glen Newsom</i>		
<i>Rt 2 Box 152 B</i>		
<i>Senatobia MS</i>		
WELL LOCATION: SEC	TOWNSHIP	RANGE
<i>12</i>	<i>6 N</i>	<i>8 E</i>
DISTANCE <i>3</i> Miles	DIRECTION <i>Sw</i>	NEAREST TOWN <i>Senatobia</i>
OTHER LANDMARK		
WELL PURPOSE: <input checked="" type="checkbox"/> Home Irrigation, <input type="checkbox"/> Municipal, <input type="checkbox"/> Industrial, <input type="checkbox"/> Fish Pond, etc.		

PUMP DATA		
PUMP TYPE (Circle One): <input checked="" type="checkbox"/> Submersible, <input type="checkbox"/> Turbine, <input type="checkbox"/> Jet, <input type="checkbox"/> Flowing Well, Other (Describe) _____		
POWER TYPE (Circle One): <input checked="" type="checkbox"/> Electric, <input type="checkbox"/> Tractor, <input type="checkbox"/> Diesel, <input type="checkbox"/> Gasoline, <input type="checkbox"/> Butane, Other (Describe) _____ H/P <i>1/2</i>		
Pump Capacity (GPM) <i>10</i>	No. of Stages	Setting Depth <i>120</i> FT.
PUMP TEST		
Well yielded _____ GPM with a drawdown of _____ ft. after _____ hours of pumping		

WELL DATA		
Well Depth <i>160</i>	Casing Diameter (In.) <i>4"</i>	Casing Length (Ft.) <i>150</i>
Type of Casing <i>Pvc</i>	Hole Depth <i>160</i>	Depth to Static Water Level <i>100</i>
TYPE OF COMPLETION: (Circle One or More): <input checked="" type="checkbox"/> Gravel Packed, <input type="checkbox"/> Underreamed, <input type="checkbox"/> Telescoped, <input type="checkbox"/> Natural Development, <input type="checkbox"/> Open Hole, <input type="checkbox"/> Other (Describe) _____		
Top of Lap Pipe or Reduction in Casing FEET <input type="checkbox"/> IF TELESCOPED OR MORE THAN ONE SCREEN: USE BACK PAGE		

LOG DATA	
TYPE OF LOG RUN (Circle One): <input type="checkbox"/> No Log Run, <input type="checkbox"/> Electric, <input type="checkbox"/> Gamma-Ray, <input type="checkbox"/> Density, <input type="checkbox"/> Sonic, <input type="checkbox"/> Neutron, Other (Describe) _____	
Name of Organization Running Log	

SCREEN DATA		
Diameter - Inches <i>4"</i>	Length - Feet <i>10'</i>	Slot Size - Inches <i>.013</i>
Screen Type <i>Pvc</i>	Depth to Bottom - Feet <i>160</i>	


GEOLOGIC DATA (Office Use Only)			
Surface Elev.	Geologic Unit	Unit Thickness	Depth to Top
Subs. SWL	Date	Analysis	Aquifer Test
Driller's Remarks			

DESCRIPTION OF FORMATIONS ENCOUNTERED	FROM	TO	FORMATIONS (Continued)	FROM	TO
<i>Red Sand</i>	<i>0</i>	<i>40</i>	RECEIVED <i>NOV 02 1993</i> Dept. of Environmental Quality Office of Land & Water Resources		
<i>SAND & CLAY</i>	<i>40</i>	<i>100</i>			
<i>White Sand</i>	<i>100</i>	<i>160</i>			

IF MORE SPACE IS NEEDED, USE BACK

If well telescopes please
sketch and show depths.

GROUND LEVEL

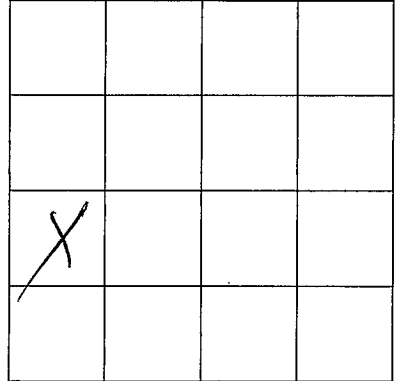

SECTION _____

Please indicate well location X.

ADDITIONAL INFORMATION

If more than one screen,
show location of each on sketch.