

MISSISSIPPI DEPARTMENT OF ENVIRONMENTAL QUALITY

Office of Land and Water Resources

COUNTY WELL LOCATED TATE	
WELL NUMBER L 8041	CODED
DATE WELL COMPLETED 11-24-95	

PERMIT NUMBER HICKS WELL CO.
NAME OF DRILLING COMPANY RT. 1 BOX 157 SENATOBIA, MS 38668

P. O. Box 10631
Jackson, MS 39289-0631
WATER WELL DRILLERS LOG

NAME & MAILING ADDRESS OF LANDOWNER SAMMY TAYLOR			
129 OAKLEY COVE			
SENATOBIA, MS.			
WELL LOCATION:	SEC	TOWNSHIP	RANGE
	13	6	N 8 E
DISTANCE	DIRECTION	NEAREST TOWN	
2 Miles	NW	of SENATOBIA	
OTHER LANDMARK			
WELL PURPOSE: Home, Irrigation, Municipal, Industrial, Fish Pond, etc. Home			

PUMP DATA		
PUMP TYPE (Circle One): <u>Submersible</u> Turbine, Jet, Flowing Well, Other (Describe) _____		
POWER TYPE (Circle One): <u>Electric</u> Tractor, Diesel, Gasoline, Butane, Other (Describe) _____ H/P <u>1/2</u>		
Pump Capacity (GPM) 10	No. of Stages 9	Setting Depth 120' FT.
PUMP TEST		
Well yielded _____ GPM with a drawdown of _____ ft. after _____ hours of pumping		

WELL DATA		
Well Depth 150'	Casing Diameter (In.) 4"	Casing Length (Ft.) 140
Type of Casing PVC	Hole Depth 150	Depth to Static Water Level 100'

TYPE OF COMPLETION: (Circle One or More):
 Gravel Packed Underreamed, Telescoped,
 Natural Development, Open Hole, Other
 (Describe) _____

WELL GROUTED TO A DEPTH OF **10'** FEET
 Type Grout (circle one): Cement, Bentonite, or Mix


SCREEN DATA		
Diameter - Inches 4"	Length - Feet 10'	Slot Size - Inches 013
Screen Type PVC	Depth to Bottom - Feet 10'	

LOG DATA			
TYPE OF LOG RUN (Circle One): No Log Run, Electric, Gamma Ray, Density, Sonic, Neutron, Other (Describe) _____			
Name of Organization Running Log			

GEOLOGIC DATA (Office Use Only)			
Surface Elev.	Geologic Unit	Unit Thickness	Depth to Top
Subs. SWL	Date	Analysis	Aquifer Test


Driller's Remarks		
Top of Lap Pipe or Reduction in Casing		
<table border="1"> <tr> <td>FEET</td> <td>IF TELESCOPED OR MORE THAN ONE SCREEN: USE BACK PAGE</td> </tr> </table>	FEET	IF TELESCOPED OR MORE THAN ONE SCREEN: USE BACK PAGE
FEET	IF TELESCOPED OR MORE THAN ONE SCREEN: USE BACK PAGE	

DESCRIPTION OF FORMATIONS ENCOUNTERED	FROM	TO
Red sand	0	40
Sand & Clay	40	120
Wh. ls Sand	120	150

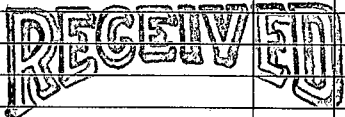FORMATIONS (Continued)	FROM	TO
 JAN 16 1996		
Dept. of Environmental Quality Office of Land & Water Resources		
IF MORE SPACE IS NEEDED, USE BACK		

If well telescopes please
sketch and show depths.

GROUND LEVEL

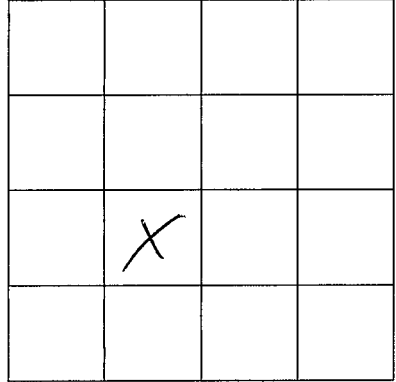

SECTION 13

Please indicate well location X.

ADDITIONAL INFORMATION

If more than one screen,
show location of each on sketch.