

TATE  
M1  
3-15-71

MISSISSIPPI  
BOARD OF WATER COMMISSIONERS  
416 North State Street  
Jackson, Mississippi 39201

**CODED**

WATER WELL DRILLERS LOG

3-15 19 71 Harris Bros. Tate  
date well completed firm name county well located

LANDOWNER: Wayne Fowler  
Pt. 1  
Senatobia  
(mailing address)

description of formations encountered	from	to
top soil	00	20
gravel + sand	20	6.5
clay + sand	6.5	120
Coarse sand	120	134

WELL LOCATION:  
sec. 7 T 6 N R 7 E  
3 1/2 miles S of Senatobia  
(distance) (direction) (nearest town)

WELL PURPOSE: none  
(home, irrigation, municipal, industrial)

- WELL COMPLETION DATA:
- (1) diameter (inches) 4
  - (2) total depth (feet) 134
  - (3) static water level (feet) 30 (below above top of ground)
  - (4) casing Plastic, 126' (material) (depth)  
4 (size) if telescope see back.
  - (5) screen 7, 126 (length) (depth to top)  
208, Plastic (size) (material)
  - (6) pump 3/4, 10 (HP) (yield gpm)  
elec. (type power)
  - (7) electric log NO (yes or no)

**CODED**

(organization running log)  
(8) how well bottom plugged well  
spot


MAY 14 1971

MISS. Bd. OF WATER COMMISSIONERS

DRILLERS REMARKS:

If well telescopes please sketch and show depths.

GROUND LEVEL

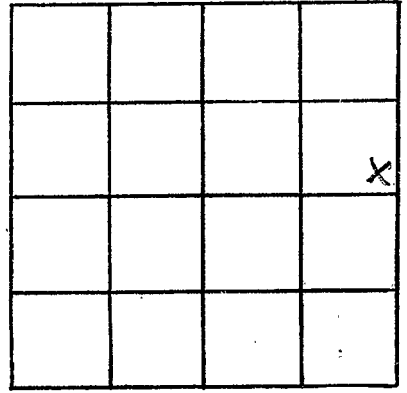

SECTION 7

Please indicate well location X.

ADDITIONAL INFORMATION

If more than one screen, show locations of each on sketch.