

MISSISSIPPI  
BOARD OF WATER COMMISSIONERS  
416 North State Street  
Jackson, Mississippi 39201

**CODED**  
**CODED**

**TATE**  
**M4**  
**11-15-71**

**WATER WELL DRILLERS LOG**

11-15 1971 Harris Bros. Tate  
date well completed firm name county well located

LANDOWNER	description of formations encountered	from	to
<u>David Lewis</u>	<u>top soil</u>	<u>0</u>	<u>15</u>
<u>PO. 1</u>	<u>red sand</u>	<u>15</u>	<u>40</u>
<u>Senatobia</u> (mailing address)	<u>clay</u>	<u>40</u>	<u>85</u>
<u>1 1/2</u> miles <u>S</u> of <u>New Town</u> (distance) (direction) (nearest town)	<u>clay + sand</u>	<u>85</u>	<u>125</u>
	<u>Coarse sand</u>	<u>125</u>	<u>140</u>

**WELL LOCATION:**

sec. 3 T. 6 N. R. 7 E.  
1 1/2 miles S of New Town  
(distance) (direction) (nearest town)

**WELL PURPOSE:** home  
(home, irrigation, municipal, industrial)

**WELL COMPLETION DATA:**

- (1) diameter (inches) 4
- (2) total depth (feet) 140
- (3) static water level (feet) 80 below above top of ground.
- (4) casing Plastic, 133'  
(material) (depth)
- 4" if telescope see back.  
(size)
- (5) screen 7', 133  
(length) (depth to top)
- 008, Plastic  
(size) (material)
- (6) pump 3/4, 7  
(HP) (yield gpm)
- elec  
(type power)
- (7) electric log no  
(yes or no)

(organization running log)

(8) how well bottom plugged solid

DRILLERS REMARKS:


**CODED**

**AUG - 7 1972**

MISS. BD. OF  
WATER COM. & S.

If well telescopes please sketch and show depths.

GROUND LEVEL

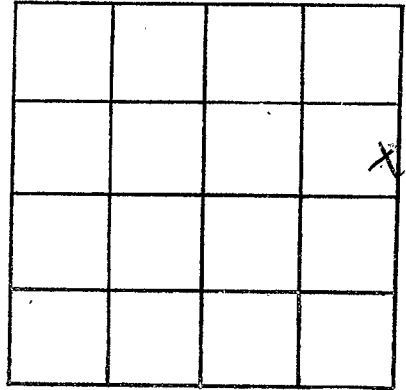

SECTION 3

Please indicate well location X.

ADDITIONAL INFORMATION

If more than one screen,  
show locations of each on sketch.