

**MISSISSIPPI
BOARD OF WATER COMMISSIONERS**
416 North State Street
Jackson, Mississippi 39201

WATER WELL DRILLERS LOG

CODED

TATE
MS
6-15-72

6-15 1972 Harris Bros. Tate
date well completed firm name county well located

LANDOWNER: R.S. Brady

309 E. Tate

Senatobia
(mailing address)

WELL LOCATION:

sec. 3 T. 6 N. R. 7 E.
3 miles SE of Senatobia
(distance) (direction) (nearest town)

WELL PURPOSE: home
(home, irrigation, municipal, industrial)

WELL COMPLETION DATA:

- (1) diameter (inches) 4
- (2) total depth (feet) 130
- (3) static water level (feet) 60 below above top of ground.
- (4) casing plastic, 116
(material) (depth)
4 If telescope see back.
(size)
- (5) screen 14, 116
(length) (depth to top)
008, plastic
(size) (material)
- (6) pump 1, 15
(HP) (yield gpm)
elec.
(type power)
- (7) electric log No
(yes or no)

(organization running log)
- (8) how well bottom plugged solid

description of formations encountered

from to

<u>top soil</u>	<u>0</u>	<u>20</u>
<u>clay + sand</u>	<u>20</u>	<u>75</u>
<u>fine sand</u>	<u>75</u>	<u>100</u>
<u>Coarse sand</u>	<u>100</u>	<u>130</u>

CODED


OCT 18 1972

DRILLERS REMARKS:

MISSISSIPPI BOARD OF WATER COMMISSIONERS
JACKSON, MISSISSIPPI

If well telescopes please sketch and show depths.

GROUND LEVEL

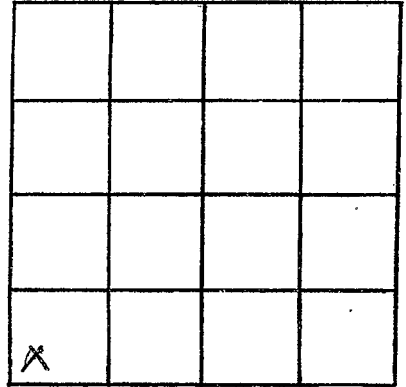

SECTION 3

Please indicate well location X.

ADDITIONAL INFORMATION

If more than one screen,
show locations of each on sketch.