

TATE
M6
5-2-72

MISSISSIPPI
BOARD OF WATER COMMISSIONERS
416 North State Street
Jackson, Mississippi 39201

WATER WELL DRILLERS LOG

CODED

5-2 1972 Harris Bros. Tate
date well completed firm name county well located

LANDOWNER: Eugene Falkner

description of formations encountered from to

pt. 1

Senatobia
(mailing address)

top soil 0 20

white clay 20 50

WELL LOCATION:

sec. 1 T 6 N R 7 E
3 1/2 miles SW of Goshome
(distance) (direction) (nearest town)

clay + sand 50 115

coarse sand 115 130

WELL PURPOSE: none
(home, irrigation, municipal, industrial)

WELL COMPLETION DATA:

(1) diameter (inches) 4
(2) total depth (feet) 130
(3) static water level (feet) 80 below top of ground.

CODED

(4) casing Plastic, 123 (material) (depth)
4 (size) if telescope, see back.

(5) screen 7 (length), 123 (depth to top)

008 Plastic (size) (material)

(6) pump 3/4 (HP), 7 (yield gpm)

elec (type power)

(7) electric log no (yes or no)

(organization running log)

(8) how well bottom plugged solid


OCT 18 1972

DRILLERS REMARKS:

MISS. BD. OF
WATER COMMISSIONERS

If well telescopes please sketch and show depths.

GROUND LEVEL

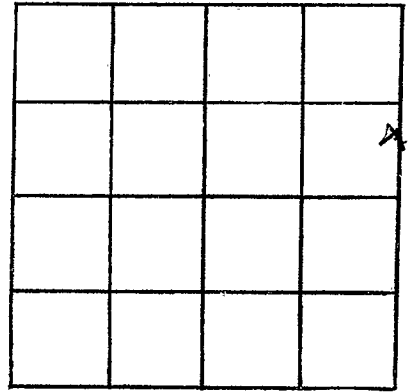

SECTION 1

Please indicate well location X.

ADDITIONAL INFORMATION

If more than one screen,
show locations of each on sketch.