

TATE
M7
10-15-72

MISSISSIPPI
BOARD OF WATER COMMISSIONERS
416 North State Street
Jackson, Mississippi 39201

WATER WELL DRILLERS LOG

CODED

10-15 1972 date well completed
Harris Bros. firm name
county well located

LANDOWNER: Henry Wooten
P.O. Box 337
Senobia
(mailing address)

description of formations encountered	from	to
top soil	0	20
fine gravel + sand	20	45
sand + clay	45	115
Coarse sand	115	130

WELL LOCATION:
sec. 1 T 6 N R 7 E
2 miles SE of New Town
(distance) (direction) (nearest town)

WELL PURPOSE: none
(home, irrigation, municipal, industrial)

WELL COMPLETION DATA:

(1) diameter (inches) 4

(2) total depth (feet) 130

(3) static water level (feet) 80 ^{below} _{above} top of ground.

(4) casing Plastic, 123
(material) (depth)
4 (size) if telescope see back.

(5) screen 7, 123
(length) (depth to top)
008, Plastic
(size) (material)

(6) pump 3/4, 7
(HP) (yield gpm)
elec.
(type power)

(7) electric log no
(yes or no)

(organization running log)

(8) how well bottom plugged sealed


CODED

DRILLERS REMARKS:

MAR 26 1973

If well telescopes please sketch and show depths.

GROUND LEVEL

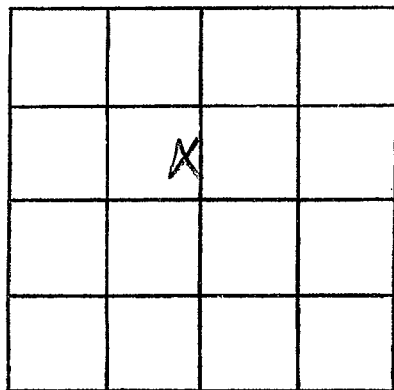

SECTION 1

Please indicate well location X.

ADDITIONAL INFORMATION

If more than one screen,
show locations of each on sketch.