

TATE
M10
6-11-73

MISSISSIPPI
BOARD OF WATER COMMISSIONERS
416 North State Street
Jackson, Mississippi 39201

WATER WELL DRILLERS LOG

6-11-1973 date well completed
Bob Hill firm name
Jato county well located

LANDOWNER:
Henry Tyler
Senatobia, Miss.
(mailing address)

description of formations encountered	from	to
clay dirt	10	20
cracked clay	20	30
white sand	30	98

WELL LOCATION:
sec. 4 T. 6 N. R. 7 E.
3 miles South of Senatobia
(distance) (direction) (nearest town)

WELL PURPOSE:
Home
(home, irrigation, municipal, industrial)

- WELL COMPLETION DATA:
- (1) diameter (inches) 4
 - (2) total depth (feet) 98
 - (3) static water level (feet) 42 below top of ground.
 - (4) casing Plank 98
(material) (depth)
 - (size) If telescope see back.
 - (5) screen 20 78
(length) (depth to top)
 - 4 Plank
(size) (material)
 - (6) pump 1/2 10
(HP) (yield gpm)
 - Elec.
(type power)
 - (7) electric log 70
(yes or no)
 - (organization running log)
 - (8) how well bottom plugged plugged


CODED

REC 27 1973

DRILLERS REMARKS:

If well telescopes please sketch and show depths.

GROUND LEVEL

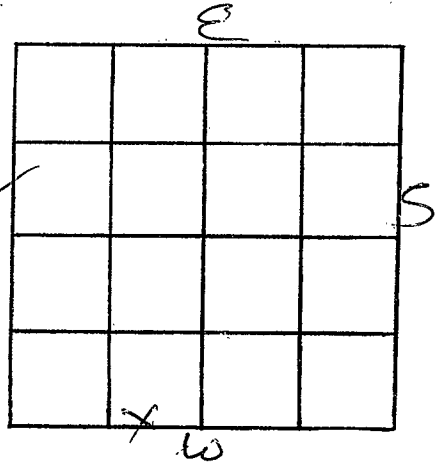

SECTION 4

Please indicate well location X.

ADDITIONAL INFORMATION

If more than one screen, show locations of each on sketch.