

TATE
M13
2-25-74

MISSISSIPPI
BOARD OF WATER COMMISSIONERS
416 North State Street
Jackson, Mississippi 39201


CODED

WATER WELL DRILLERS LOG

2-25-74 1974 Bob Smith Inte
date well completed firm name county well located


LANDOWNER:	description of fomations encountered	from	to
Verdie Newman			
Senatobia, Miss (mailing address)	Red clay	5'	35'
WELL LOCATION:	Red gravel	35'	55'
sec. 2 T. 6 N. R. 7 E 4 miles S of New Town (distance) (direction) (nearest town)	white sand	55'	135'
WELL PURPOSE: Home (home, irrigation, municipal, industrial)			
WELL COMPLETION DATA:			
(1) diameter (inches) 4			
(2) total depth (feet) 135			
(3) static water level (feet) 87 below top of ground.			
(4) casing Plastic, 135 (material) (depth)			
(size) If telescope see back.			
(5) screen 20 115 (length) (depth to top)			
4 Plastic (size) (material)			
(6) pump 1/2 10 (HP) (yield gpm)			
Elec (type power)			
(7) electric log 70 (yes or no)			
(organization running log)			
(8) how well bottom plugged plugged			
DRILLERS REMARKS:			

CODED

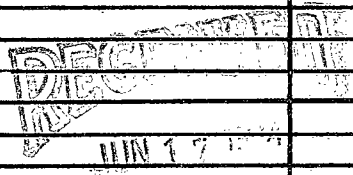

If well telescopes please sketch and show depths.

GROUND LEVEL

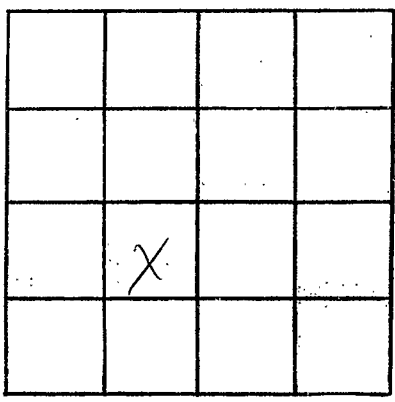

SECTION 2

Please indicate well location X.

ADDITIONAL INFORMATION

If more than one screen, show locations of each on sketch.