

TATE
M 14
3-29-74

MISSISSIPPI
BOARD OF WATER COMMISSIONERS **CODED**
416 North State Street
Jackson, Mississippi 39201

WATER WELL DRILLERS LOG


3-29-1974 Bob Smith Tate
date well completed firm name county well located

LANDOWNER:	description of formations encountered	from	to
<u>David Jones</u>			
<u>Senatchee, Miss.</u> (mailing address)	<u>Clay</u>	<u>5'</u>	<u>40'</u>
WELL LOCATION:	<u>Sand</u>	<u>40'</u>	<u>120'</u>
sec. <u>4</u> T <u>6</u> N R <u>7</u> E			
<u>4</u> miles <u>SE</u> of <u>Senatchee</u> (distance) (direction) (nearest town)			
WELL PURPOSE: <u>Home</u> (home, irrigation, municipal, industrial)			
WELL COMPLETION DATA:			
(1) diameter (inches) <u>4</u>	CODED		
(2) total depth (feet) <u>120</u>			
(3) static water level (feet) <u>70</u> below top of ground.			
(4) casing <u>Plastic 120</u> (material) (depth)			
(size) if telescope see back.			
(5) screen <u>20</u> <u>100</u> (length) (depth to top)			
<u>4</u> <u>Plastic</u> (size) (material)			
(6) pump <u>1/2</u> <u>10</u> (HP) (yield gpm)			
<u>Elec.</u> (type power)			
(7) electric log <u>no</u> (yes or no)			
(organization running log)			
(8) how well bottom plugged <u>plugged</u>			
DRILLERS REMARKS:			

RECEIVED
MAY 17 1974
MISS. RD. OF WATER COMMISSIONERS

If well telescopes please sketch and show depths.

GROUND LEVEL

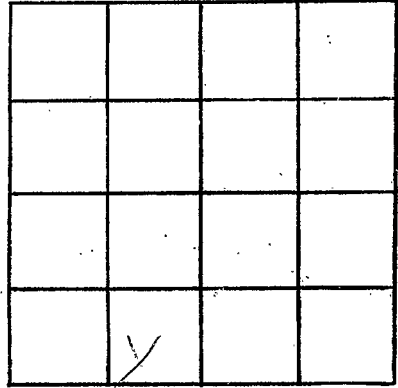

SECTION 4

Please indicate well location X.

ADDITIONAL INFORMATION

If more than one screen, show locations of each on sketch.