

**MISSISSIPPI  
BOARD OF WATER COMMISSIONERS**  
416 North State Street  
Jackson, Mississippi 39201

**CODED**

Date
M 16
9-26-69

**WATER WELL DRILLERS LOG**

SEPT. 26 1969 J. LEON WHITE DATE  
 date well completed firm name county well located

LANDOWNER: <u>HEESTONE FARMS</u> RT. 2 BOX 161 SENATOBIA, Miss. (mailing address)	Description of formations encountered	from	to
		Top Soil	0
	Red Sand	22	32
	White Clay	32	44
	Mixed Sand & Clay	44	75
	Gravel	75	95
	White Med. Sand	95	140

**WELL LOCATION:**

sec. B T 6 N R 7 E  
 (S) (W)  
4 miles S of SENATOBIA  
 (distance) (direction) (nearest town)

**WELL PURPOSE:** DRINK  
 (home, irrigation, municipal, industrial)

**WELL COMPLETION DATA:**

- diameter (inches) 4"
- total depth (feet) 140
- static water level (feet) 82 below above top of ground.
- casing PLASTIC, 140  
 (material) (depth)  
4" if telescope see back.  
 (size)
- screen 5', 140  
 (length) (depth to top)  
4", SAND PACKED PLASTIC  
 (size) (material)
- pump 3/4, 10 G.P.M.  
 (HP) (yield gpm)  
ELE.  
 (type power)
- electric log NO.  
 (yes or no)

(organization running log)

(8) how well bottom plugged SPRINKER


**DRILLERS REMARKS:**

OCT 16 1969

MISS. BD. OF  
 WATER COMM.

If well telescopes please sketch and show depths.

GROUND LEVEL

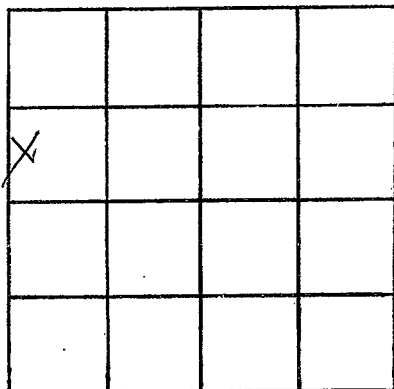

SECTION 8

Please indicate well location X.

ADDITIONAL INFORMATION

If more than one screen,  
show locations of each on sketch.