

CODED

MISSISSIPPI
BOARD OF WATER COMMISSIONERS
416 North State Street
Jackson, Mississippi 39201

WATER WELL DRILLERS LOG

TATE
M 17,
H-10069

11-15 1969 date well completed
Harris Bros firm name
Tate county well located

LANDOWNER: Jack Cleveland

P.O. 1 Box 335B

Senatobia
(mailing address)

WELL LOCATION:

sec. 2 T 6 N R 7 E
8 miles SE of Senatobia
(distance) (direction) (nearest town)

WELL PURPOSE: home
(home, irrigation, municipal, industrial)

WELL COMPLETION DATA:

- (1) diameter (inches) 4
- (2) total depth (feet) 130
- (3) static water level (feet) 80 below top of ground.
- (4) casing Plastic, 123' (material) (depth)
4" (size) if telescope see back.
- (5) screen 7' 123' (length) (depth to top)
008 Plastic (size) (material)
- (6) pump 3/4 7 (HP) (yield gpm)
elec. (type power)
- (7) electric log no (yes or no)

(organization running log)

(8) how well bottom plugged brack
shot

DRILLERS REMARKS:

description of formations encountered

from

to


top soil	0	20
red sand + peagruel	20	65
sand + clay	65	115
coarse sand	115	130

DEC 29 1969

MISS. BD. OF
WATER COMM.

If well telescopes please sketch and show depths.

GROUND LEVEL

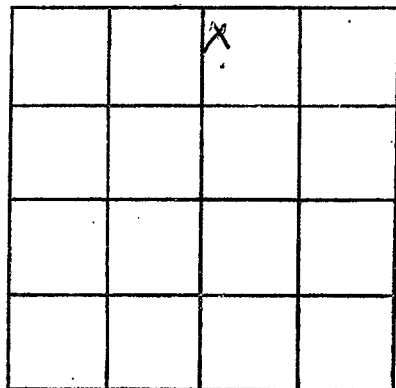

SECTION 2

Please indicate well location X.

ADDITIONAL INFORMATION

If more than one screen,
show locations of each on sketch.