

TATE
 M 20
 3-20-74

MISSISSIPPI
 BOARD OF WATER COMMISSIONERS
 416 North State Street
 Jackson, Mississippi 39201

CODED

WATER WELL DRILLERS LOG

3-20-74 date well completed 1974 firm name *Bob Smith* Late county well located


LANDOWNER:	description of formations encountered	from	to
<i>Willie Mae Lowrey</i>			
<i>Senatobia, Miss.</i> (mailing address)	<i>Red clay</i>	<i>5'</i>	<i>30'</i>
WELL LOCATION:	<i>Gravel</i>	<i>30'</i>	<i>45'</i>
sec. <u>2</u> T <u>6</u> N R <u>7</u> E	<i>Sand</i>	<i>45'</i>	<i>165'</i>
<u>2 1/2</u> miles <u>South</u> of <u>New Town</u> (distance) (direction) (nearest town)			
WELL PURPOSE: <u>Home</u> (home, irrigation, municipal, industrial)			
WELL COMPLETION DATA:			
(1) diameter (inches) <u>4</u>			
(2) total depth (feet) <u>165</u>			
(3) static water level (feet) <u>100</u> below top of ground.			
(4) casing <u>Plastic</u> <u>165</u> (material) (depth)			
(size) if telescope see back.			
(5) screen <u>20</u> <u>145</u> (length) (depth to top)			
<u>4</u> <u>Plastic</u> (size) (material)			
(6) pump <u>1/2</u> <u>10</u> (HP) (yield gpm)			
<u>Elec.</u> (type power)			
(7) electric log <u>no</u> (yes or no)			
(organization running log)			
(8) how well bottom plugged <u>plugged</u>			
DRILLERS REMARKS:			

CODED

MISS. BOARD OF WATER COMMISSIONERS
 JUN 27 1974

If well telescopes please sketch and show depths.

GROUND LEVEL

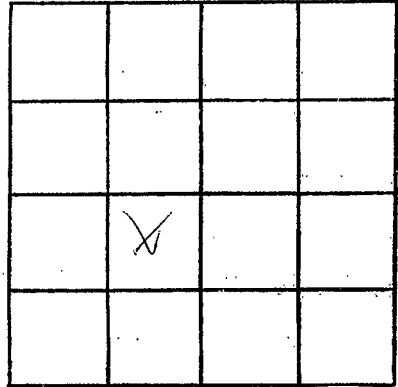

SECTION 2

Please indicate well location X.

ADDITIONAL INFORMATION

If more than one screen, show locations of each on sketch.