

TATE  
 M 21  
 3-23-74

MISSISSIPPI  
 BOARD OF WATER COMMISSIONERS  
 416 North State Street  
 Jackson, Mississippi 39201

CODED

WATER WELL DRILLERS LOG

3-23-1974 date well completed      Bob Smith firm name      Tate county well located


LANDOWNER:	description of fomations encountered	from	to
Ernie Shuge			
Anatoka, Miss. (mailing address)	Red clay	5'	30'
WELL LOCATION:	Gravel	30'	45'
sec. 2 T 6 N R 7 E 3 miles S of Newbon (distance) (direction) (nearest town)	Sand	45'	165'
WELL PURPOSE: Home (home, irrigation, municipal, industrial)			
WELL COMPLETION DATA:			
(1) diameter (inches) 4			
(2) total depth (feet) 100			
(3) static water level (feet) 85 below top of ground.			
(4) casing Plastic 100 (material) (depth)			
(size) if telescope see back.			
(5) screen 20 80 (length) (depth to top)			
4 Plastic (size) (material)			
(6) pump 1/2 10 (HP) (yield gpm)			
Elec. (type power)			
(7) electric log 70 (yes or no)			
(organization running log)			
(8) how well bottom plugged plugged			
DRILLERS REMARKS:			

CODED

RECORDED  
 1974

If well telescopes please sketch and show depths.

GROUND LEVEL

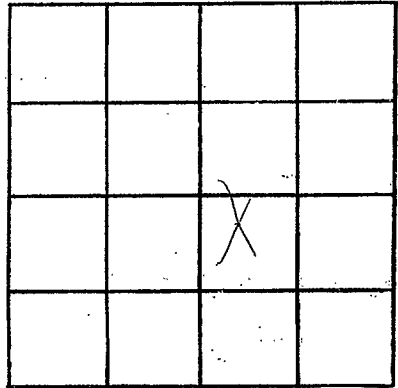

SECTION 2

Please indicate well location X.

ADDITIONAL INFORMATION

If more than one screen, show locations of each on sketch.