

TATE
M23
10/2/74

MISSISSIPPI
BOARD OF WATER COMMISSIONERS
416 North State Street
Jackson, Mississippi 39201

WATER WELL DRILLERS LOG

CODED

10-2
date well completed

1974 Bob Smith Well
firm name Drilling

Tate
county well located

LANDOWNER: Elton McDaniel

description of formations encountered

from

to

Rt. 2
Caldwater, Miss
(mailing address)

red clay	0	15
sand & gravel	15	70
white clay	70	75
fine white sand	75	160
heavy sand	160	190

WELL LOCATION:

sec. 2 T. 6 N. R. 7 E.
5 miles east of Caldwell
(distance) (direction) (nearest town)

WELL PURPOSE: Home
(home, irrigation, municipal, industrial)

WELL COMPLETION DATA:

- (1) diameter (inches) 4
- (2) total depth (feet) 190
- (3) static water level (feet) 120 below top of ground.
- (4) casing plastic, 190
(material) (depth)

 if telescope see back.
(type power)

(7) electric log no
(yes or no)

(organization running log)

(8) how well bottom plugged plugged

DRILLERS REMARKS:


CODED

RECEIVED
OCT 23 1974

MISS. DD. OF WATER COMMISSIONERS

If well telescopes please sketch and show depths.

GROUND LEVEL

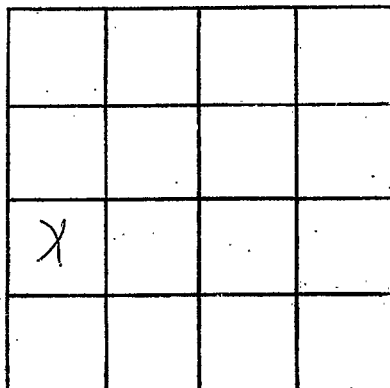

SECTION _____

Please indicate well location X.

ADDITIONAL INFORMATION

If more than one screen,
show locations of each on sketch.