<u>.</u>	- State We	ll Report	
TATE	Pa	-	For Office Use Only:
County:	1	of Environmental Quality	Aquifer:
Permit #:		Office of Land and Water Resources	
Driller: COB SMATH	P.O. Bo		Well#: <u>M-45</u>
Date drilling completed: <u>-/-/0-06</u>		39289-0631 51-5210	L. S. Elevation:
Date artiling completed:		6938 (fax)	E-log #:
State Law requires that this rep		riller in detail and filed w	ith the Department withi
30 days of completion of drilling Well Owner Inform		Wel	Location
	Dwner Name_ <u>L.T.</u> BISHOPLatitude:'' Longitude:		
Mailing Address: <u>386</u> 6	WEN	Method of Lat/Long (circle or	ae): Conventional Survey,
		USGS quad, Hand-held	GPS, Survey-grade GPS
SEMMORA, MS. 3868		1/4 1/4 Car / M-	9 Twn 765 Rng R.
City State Zip Code			
Telephone No. (66) 560-	5489	Distance Direction	Nearest Town
	Well Da	ita	
Purpose of Well (circle one) (Home) In	dustrial Public Supply	Irrigation Fish Culture	Other:
Date well drilling started:			
Date well drilling started:	Date we	all drilling completed:	7-70-00
If flowing, method of flow regulation: Va	alve Other (des	cribe)	
Static Water Level:feet a	bove or below (circle one) lar	ad surface Date measured:	4-10-06
	steel tape electric tape		
Hole depth: Well de	epth:	Well grouted to a depth of _	feet
Type of grout (circle one):	Bentonite Mix		
			1 m
Casing length:feet Cas	ing diameter: <u> </u>	inches Type of casing: _	PUC
Screen length:feet Scr	een diameter:	inches Type of screen:	PUC
-			105
Screen slot size: <u>/4 thus</u> inches	Setting depth: From	$\delta > $ feet to	<u>feet</u>
Type of completion (circle all applicable)	: Gravel packed Underre	amed Telescoped Open	hole Natural Developmen
	Other (describe):	WASHER S	The A
			- / - //
Top of lap pipe or reduction in casing:	feet. If tele	scoped or more than one scr	een, describe on back of pag
Logs run (circle all applicable): No log r	un Electric Gamma Ray	Density Sonic Neutron	Other:
Name of organization running log(s):			
I certify that the well was drilled, const	ructed, and completed in ac	cordance with all applicable	requirements of the Mississi
			-
Department of Environmental Quality	and/of the MISSISSIDUL Densi		11 A
Department of Environmental Quality		1	
Department of Environmental Quality	анкиот ше мъзызарр Бери 174 - О-64	5 <1.	MAD

MAY 11 2006 BY: OLWR :


If well telescopes please sketch below and show depths.

M-45

2

Ground Level		Description of Formations Encountered	From	To
		TOP SOIL	0	I
		Brown CIAJ	5	20
		GREJ + WHITE CIAL	20	70
		SAND	70	100
		BLIE CIAJ	100	105
			-	
				<b></b>
				+
	1			

If more than one screen, show location of each on sketch

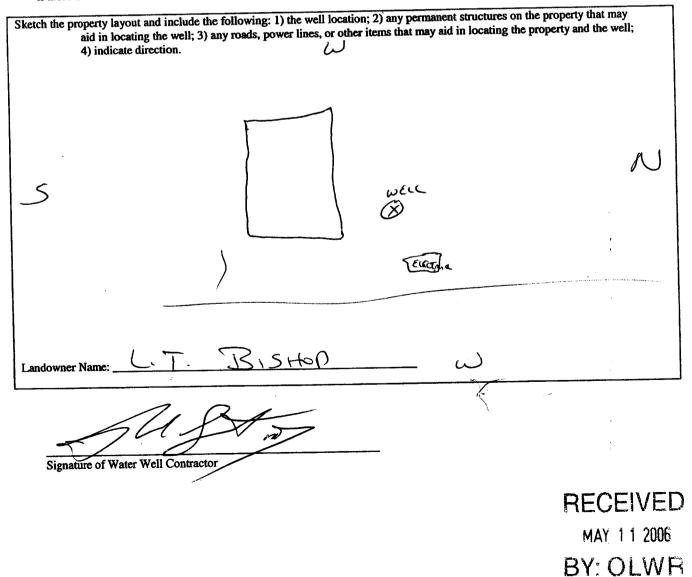

STATE WELL REPORT				
County:       PTE       Pump Installer's         Permit #:       Mississippi Department         Driller:       Bob Smi Tid       P.O. I         Date completed:       4-10-06       (601)35	art 2       For Office Use Only:         s Completion Report       Aquifer:         art of Environmental Quality       Aquifer:         and Water Resources       Well #: <u>M - 455</u> Box 10631       Box 39289-0631         961-5210       Elevation:         4-6938 (fax)       Elevation:			
This report should be prepared by the pump installer in detail and filed with the Department within 30 days of the installation of pump. Well Owner Information Well Location				
Well Owner Information				
Owner Name:BISHDP	Latitude: Longitude:			
Mailing Address: 386 GWEN	Method of Lat/Long (circle one): Conventional Survey,			
	USGS quad, Hand-held GPS, Survey-grade GPS			
<u>SEMANURA M3. 38668</u> City State Zip Code	$- 4 - 4 \sec (M - 9) \operatorname{Twn} T65 \operatorname{Rng} (R - 16)$			
City State Zip Code	Distance Direction Nearest Town			
Telephone No. (663 560-5489	<u>_3</u> Miles <u>5/E of SENAJOBIA</u>			
Pump Type Circle one	Power Type Circle one			
Air Lift Jet Submersible	Diesel Engine Gasoline Engine Natural Gas			
Bucket Piston Turbine	Electric Motor Hand Tractor PTO			
Centrifugal Rotary Flowing Well	Windmill Other (specify):			
Other (specify):	Horse Power Rating of Motor:			
Date Pump Installed:	Setting Depth:feet			
Rated Pump Capacity: Gallons Per Minute	Number of Stages:			
Pump Test Data	Method of Measuring Water Level			
Date Well Tested:	Circle one			
Static Water Level (A):Feet Below Land Surface	Air Line Electric Measuring Line Steel Tape			
Pumping Water Level (B):Feet Below Land Surface	Other (specify):			
Drawdown [(B) – (A)]:Feet Below Land Surface	For flowing well, measured shut in head:feet			
Test Pumping Rate:Gallons Per Minute	Well yieldedGPM with a drawdown of			
Duration of Pump Test (minimum 4 hours):hours	feet afterhours of pumping			
	J			
I HEREBY CERTIFY that the above statements are true to the best of my knowledge.				
SOB Smith 0-1045 Marth				
Print Name of Pump Installer and License No. (if applicable) Signature of Pump Installer				

RECEIVED MAY 11 2006 BY: OLWR :