1		State Well Report	For Office Use Only:	
	County: Tate	Part 1 – Driller's Log	For Office Use Only.	
	County:	Mississippi Department of Environmental Quality	Aquifer:	
	Permit #:	Office of Land and Water Resources	Well #: 1-50	
	Driller: Jones w. Mason	P.O. Box 10051	Weil #.	
		Jackson, MS 39289-0631	L. S. Elevation:	
	Date drilling completed: 1-9-07	(601)961-5210		
	51	(601)354-6938 (fax)	E-log #:	

State Law requires that this report be prepared by the license holder responsible for the work and filed with the Department at the above address within 30 days of completion of drilling of the well or borehole.

Information on Well Owner	Well or Borehole Location			
(Landowner if borehole is not for a water well)	24 24 24 24			
0	Latitude 34 .34 .040 " Longitude: 89 . 55, 463,			
Owner Name Bart Scruggs	Method of Lat/Long (circle one): Conventional Survey,			
Mailing Address: Como Trace Suddisen	USGS quad, Hand-held GPS, Survey-grade GPS			
LOT #1	NW 1/4 NE 1/4 Sec 15 Twn 65 Rng 7w			
Senatobia Ms 38600 City State Zip Code				
	Distance Direction Nearest Town field			
Telephone No. (662) 560 - 8083	•			
Well / Bore				
Date drilling started: $1-9-07$ Date drilling completed: $1-9-07$ Hole depth: $125'$ Hole diameter: $6^{3/4}$				
Location of the source of any surface water used for drilling: <u>NA</u> Method of dosing and volume of Chlorine used in drilling and development: <u>NA</u>				
Logs run (circle all applicable). No log run Electric Gamma Ray Density Sonic Neutron Other:				
Purpose of borehole (check one): Water Well Geotechnical/Geological Investigation Ground Source Heat Pump				
Seismic Survey Other (<i>describe</i>)				
Purpose of Well (check one): HomeIndustrial Public Supply Irrigation Fish Culture Other:				
If a flowing well, method of flow regulation: Valve Other (describe)				
Static Water Level:feet above or below circle one) land surface Date measured:				
Method of Measurement (circle one) steel tape electric tape air line other: string [weight				
Well depth: 125 Well grouted to a depth of 10 feet Type of grout (circle one): Neat Cement Bentonity Mix				
Casing length: 105 feet Casing diameter: inches Type of casing:				
Screen length: <u>30</u> feet Screen diameter: <u>4</u> inches Type of screen: <u>psc</u>				
Screen slot size: 010 inches Setting depth: From 105 feet to 125 feet				
Type of completion (circle all applicable): Gravel packed Underreamed Telescoped Open hole Natural Development				
Other (describe):				
Top of lap pipe or reduction in casing:feet. If telescoped or more than one screen, describe on next page				
	Form: OLWR-SWR-			

Form: OLWR-SWR-1A RECEIVED FEB 0 6 2007 BY: OLWR

M-30


The sketch below only required for water wells

If well telescopes, show depths on sketch. Ground Level_

Description of formations encountered must be provided for all wells and boreholes, unless specifically exempted by regulations

 Description of Formations Encountered	From (depth) Ground Level	30
white class	30	50
white soud	50	125
	-	
		+

If more than one screen, show location of each on sketch

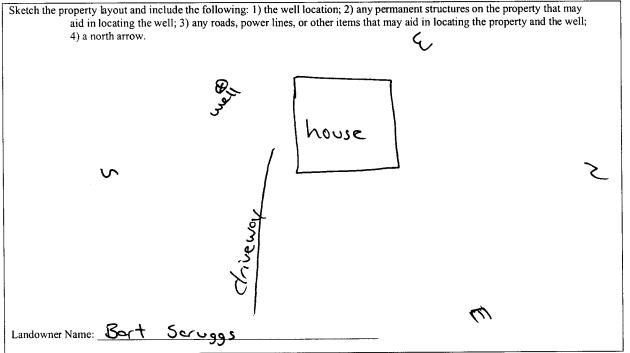

Form: OLWR-SWR-1A

I certify that the well/borehole was drilled, constructed, and completed in accordance with all applicable requirements of the Mississippi Department of Environmental Quality and the Mississippi Department of Health regulations, if applicable, and state

laws. JomesMason0-6202-3-07Print Name of Responsible Licensee and License No.Date

<u>Jono w. Moon</u> Signature of Licensee

Leaf from the form of the form FEB 0 8 2007 BY: OLMR

STATE WELL REPORT						
County: Tate Pump Installer? Permit #:	Part 2 's Completion Report ent of Environmental Quality and Water Resources Box 10631 MS 39289-0631 1)961-5210 54-6938 (fax) R contractor or a licensed pump installer. A copy of Part 1 of the					
<u>LET #1</u> <u>Servetubia MS 38668</u> City State Zip Code Telephone No. (662) 560-8083	USGS quad, Hand-held GPS, Survey-grade GPS <u>NW % NE % Sec_15_T_65_R_7</u> Distance Direction Nearest Town <u>2'la Miles_Wof_Spring Feild</u>					
Pump Type Circle one	Power Type Circle one					
Air Lift Jet Submersible Bucket Piston Turbine Centrifugal Rotary Flowing Well Other (specify):	Diesel Engine Gasoline Engine Natural Gas Electric Motor Hand Tractor PTO Windmill Other (specify):					
Pump Test Data Date Well Tested: 1~19-07 Static Water Level (A): QO Feet Below Land Surface Pumping Water Level (B): NA Feet Below Land Surface Drawdown [(B) - (A)]: NA Feet Below Land Surface Test Pumping Rate: QO Gallons Per Minute Duration of Pump Test (minimum 4 hours): QY hours	Method of Measuring Water Level Circle one Air Line Electric Measuring Line Steel Tape Other (specify): String [useight For flowing well, measured shut in head: NA					

I HEREBY CERTIFY that the above statements are true to the best of my knowledge. <u>Janes w. Masow</u> 0-620 Print Name of Pump Installer and License No. (if applicable) Form: OLWR-SWR-18 Signature of Pump Installer

> FEB 16 2007 BY: OLVVA