

MISSISSIPPI
BOARD OF WATER COMMISSIONERS
416 North State Street
Jackson, Mississippi 39201

WATER WELL DRILLERS LOG

Date
M 2000
7-68

7-1 1968 date well completed
J B Cain firm name
TATE county well located

LANDOWNER: BACK ACRES
COUNTRY CLUB
SENATORIA MISS
(mailing address)

description of formations encountered	from	to
Brk of Sand	0	30
	30	80

WELL LOCATION:
sec. 9 T 6 N R 7 E
5 miles SE of SENATORIA
(distance) (direction) (nearest town)

WELL PURPOSE:
(home, irrigation, municipal, industrial)

WELL COMPLETION DATA:

(1) diameter (inches) 4"

(2) total depth (feet) 80 FT

(3) static water level (feet) 42 below top of ground


(4) casing PEOSTIC 80 FT (material) (depth)
4" (size) If telescope see back.

(5) screen 10 70 (length) (depth to top)
4 (size) Filter Pack (material)

(6) pump 5 76 (HP) (yield gpm)
Electric (type power)

(7) electric log NO (yes or no)
(organization running log)


(8) how well bottom plugged wash Bottom

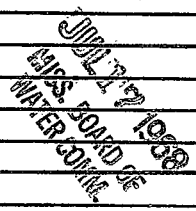

DRILLERS REMARKS:

If well telescopes please sketch and show depths.

GROUND LEVEL

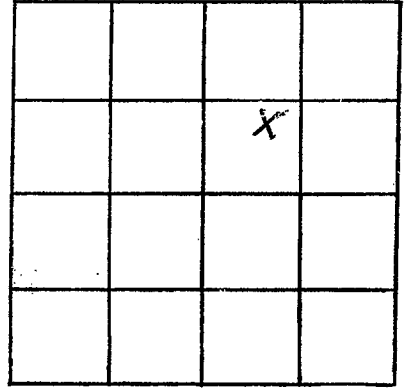

SECTION 9

Please indicate well location X.

ADDITIONAL INFORMATION

If more than one screen,
show locations of each on sketch.