

Inte
 M 2001
 7-68

MISSISSIPPI
 BOARD OF WATER COMMISSIONERS
 416 North State Street
 Jackson, Mississippi 39201

WATER WELL DRILLERS LOG

7-3 1968 *T B Cain* *Tate*
 date well completed firm name county well located

LANDOWNER: *Back acres*
Country Club
Senatobia Miss
 (mailing address)

description of formations encountered	from	to
<i>Top of Sand</i>	<i>0</i>	<i>80</i>
	<i>80</i>	<i>170</i>

WELL LOCATION:
 sec. *9* T. *6* N. *7* E
5 miles *SE* of *Senatobia*
 (distance) (direction) (nearest town)

WELL PURPOSE:
 (home, irrigation, municipal, industrial)


WELL COMPLETION DATA:

- (1) diameter (inches) *4"*
- (2) total depth (feet) *120*
- (3) static water level (feet) *60* below above top of ground.
- (4) casing *Plastic, 110*
 (material) (depth)
4 If telescope see back:
 (size)
- (5) screen *10, 110*
 (length) (depth to top)
4, Filter Pocket
 (size) (material)
- (6) pump *3, 60*
 (HP) (yield gpm)
Electric
 (type power)
- (7) electric log *no*
 (yes or no)

(organization running log)


(8) how well bottom plugged *wash Ballou*

DRILLERS REMARKS:

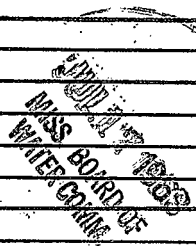

If well telescopes please sketch and show depths.

GROUND LEVEL

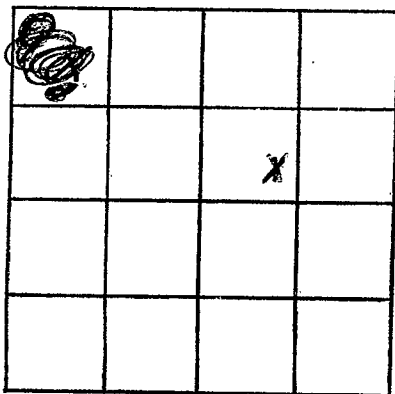

SECTION 9

Please indicate well location X.

ADDITIONAL INFORMATION

If more than one screen,
show locations of each on sketch.