

TATE
 M 2003
 12-19-75

15E

MISSISSIPPI
 BOARD OF WATER COMMISSIONERS
 416 North State Street
 Jackson, Mississippi 39201

WATER WELL DRILLERS LOG

12-19-75 date well completed Sub Smith Well Co. firm name Tate county well located

LANDOWNER: Arthur Sweet
 Senobia, Miss (mailing address)
 WELL LOCATION: sec. 7 T 6 N R 1 E
 3 miles S. W. of Senobia (distance) (direction) (nearest town)

description of formations encountered	from	to
top soil	0	2
red clay	5	15
gravel	15	45
white clay	45	50
sand	50	130
blue clay	130	150
white sand	150	195

WELL PURPOSE: Home (home, irrigation, municipal, industrial)

WELL COMPLETION DATA:
 (1) diameter (inches) 4
 (2) total depth (feet) 195
 (3) static water level (feet) 85 below top of ground.
 (4) casing plastic (material), 195 (depth)
 (size) If telescope see back.
 (5) screen 10 (length), 185 (depth to top)
 4 (size), plastic (material)
 (6) pump 1/3 (HP), 10 (yield gpm)
 E See (type power)
 (7) electric log (yes or no)
 (organization running log)


(8) how well bottom plugged plugged

DRILLERS REMARKS:

RECEIVED
 FEB 23 1976

If well telescopes please sketch and show depths.

GROUND LEVEL

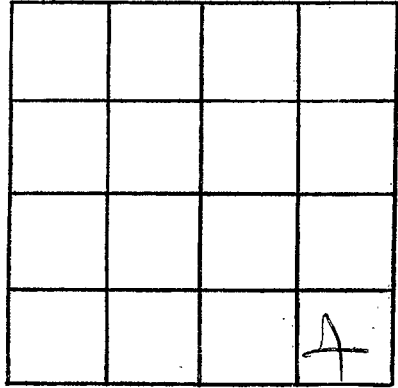

SECTION _____

Please indicate well location X.

ADDITIONAL INFORMATION

If more than one screen,
show locations of each on sketch.