

TATE
M 2004
6-23-77

MISSISSIPPI
BOARD OF WATER COMMISSIONERS
416 North State Street
Jackson, Mississippi 39201

WATER WELL DRILLERS LOG

date well completed 6-23, 1977 firm name Hicks Well Co. county well located Tate

LANDOWNER: James Johnson
Ret. 1
Come, Mo.
(mailing address)

description of formations encountered	depth	
	from	to
<u>Red clay</u>	<u>0</u>	<u>10</u>
<u>Gravel</u>	<u>10</u>	<u>80</u>
<u>White sand</u>	<u>80</u>	<u>105</u>

WELL LOCATION:
sec. 14 T. 6 N. R. 7 E. W
6 miles SE of Senatobia
(distance) (direction) (nearest town)

WELL PURPOSE: Domestic
(home, irrigation, municipal, industrial)

WELL COMPLETION DATA:

(1) diameter (inches) 4

(2) total depth (feet) 105

(3) static water level (feet) 80 below/above top of ground.

(4) casing PVC 105
(material) (depth)

(size) If telescope see back.

(5) screen 7' 98'
(length) (depth to top)

4" gravel type
(size) (material)

(6) pump 1/2 10
(HP) (yield gpm)

220-V
(type power)

(7) electric log Y10
(yes or no)

(organization running log)


(8) how well bottom plugged Cap

RECEIVED

DRILLERS REMARKS:

If well telescopes please sketch and show depths.

GROUND LEVEL

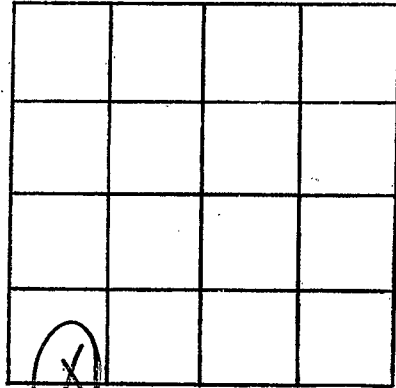

SECTION 14

Please indicate well location X.

ADDITIONAL INFORMATION

If more than one screen, show locations of each on sketch.