

TATE
 M 2005
 6/19/78

MISSISSIPPI
 BOARD OF WATER COMMISSIONERS
 416 North State Street
 Jackson, Mississippi 39201

WATER WELL DRILLERS LOG

6-19 1978 date well completed
 Tate firm name
 Tate county well located

LANDOWNER: <u>Sam Hardin</u>	description of formations encountered	from	to
<u>Plot 1</u>			
<u>Senatobia, MS</u> (mailing address)	<u>Red Clay</u>	<u>0</u>	<u>7</u>
	<u>White Clay</u>	<u>7</u>	<u>60</u>
	<u>Black Clay</u>	<u>60</u>	<u>90</u>
	<u>White Clay & Sand</u>	<u>90</u>	<u>138</u>
	<u>White Sand</u>	<u>138</u>	<u>165</u>
WELL LOCATION: sec. <u>12</u> T. <u>6</u> N. R. <u>7</u> E. (distance) (direction) (nearest town) <u>Travel Springs</u>			
WELL PURPOSE: <u>Home</u> (home, irrigation, municipal, industrial)			
WELL COMPLETION DATA:			
(1) diameter (inches) <u>4</u>			
(2) total depth (feet) <u>165</u>			
(3) static water level (feet) <u>80</u> below top of ground.			
(4) casing <u>PVC, 165</u> (material) (depth)			
(size) if telescope see back.			
(5) screen <u>7</u> <u>158</u> (length) (depth to top)			
<u>4</u> <u>gravel type</u> (size) (material)			
(6) pump <u>1/2</u> <u>10</u> (HP) (yield gpm)			
<u>220V</u> (type power)			
(7) electric log <u>no</u> (yes or no)			
(organization running log)			
(8) how well bottom plugged <u>Cap</u>			
DRILLERS REMARKS:			


RECEIVED

JUNE 29 1978

MISS. BD. OF WATER COMMISSIONERS

If well telescopes please sketch and show depths.

GROUND LEVEL

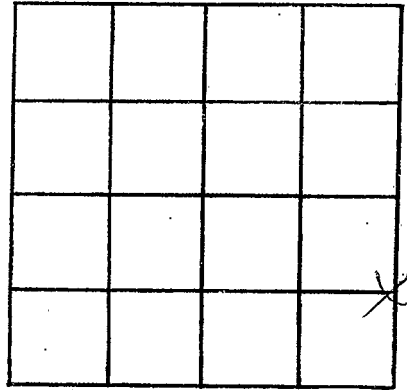

SECTION

12

Please indicate well location X.

ADDITIONAL INFORMATION

If more than one screen,
show locations of each on sketch.