

TATE
 M 2000
 6/20/79

MISSISSIPPI
 BOARD OF WATER COMMISSIONERS
 416 North State Street
 Jackson, Mississippi 39201

WATER WELL DRILLERS LOG

6-20 1979 P.P. High Well Co. Tate
 date well completed firm name county well located

LANDOWNER: Laura Buford
 Rt. 1, Box 304
 Senatobia, Mo.
 (mailing address)

| description of formations encountered | from | to |
|---------------------------------------|------|-----|
| Red Clay | 0 | 10 |
| Red Sand | 10 | 26 |
| Gravel & Sand | 26 | 60 |
| Gravel Sand Red Sand | 60 | 110 |
| Sand | 110 | 140 |

WELL LOCATION:
 sec. 13 T 6 N R 7 E
 (distance) (direction) (nearest town)

WELL PURPOSE: Home
 (home, irrigation, municipal, industrial)

- WELL COMPLETION DATA:
- (1) diameter (inches) 4
 - (2) total depth (feet) 140
 - (3) static water level (feet) 60 below top of ground.
 - (4) casing PVC 140 (material) (depth)
 (size) if telescope see back.
 - (5) screen 7 133 (length) (depth to top)
 4" gravel type (size) (material)
 - (6) pump 1/2 10 (HP) (yield gpm)
 220V (type power)
 - (7) electric log No (yes or no)
 - (8) how well bottom plugged Cap
 (organization running log)


DRILLERS REMARKS:

RECEIVED
 JUN 29 1979

MISS. BD. OF WATER COMMISSIONERS

If well telescopes please sketch and show depths.

GROUND LEVEL

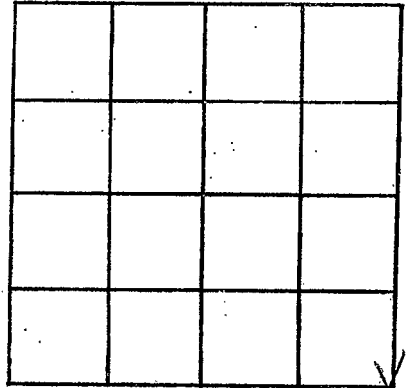

SECTION

13

Please indicate well location X.

ADDITIONAL INFORMATION

If more than one screen, show locations of each on sketch.