

TATE
 M 2007
 5/16/78

MISSISSIPPI
 BOARD OF WATER COMMISSIONERS
 416 North State Street
 Jackson, Mississippi 39201

WATER WELL DRILLERS LOG

5-16-1978 date well completed
 Hink Well Co. firm name
 Tate county well located


LANDOWNER: <u>Rubin Tate</u>	description of formations encountered	from	to
<u>Senatobia, Ms.</u> (mailing address)	<u>Red Clay</u>	<u>0</u>	<u>10</u>
	<u>Gravel</u>	<u>10</u>	<u>15</u>
WELL LOCATION: sec. <u>6</u> T. <u>6</u> N. R. <u>7</u> E. <u>1</u> miles <u>SE</u> of <u>Senatobia</u> (distance) (direction) (nearest town)	<u>Red sand</u>	<u>15</u>	<u>45</u>
	<u>Clay + Gravel</u>	<u>45</u>	<u>75</u>
WELL PURPOSE: <u>Home</u> (home, irrigation, municipal, industrial)	<u>Red sand</u>	<u>75</u>	<u>100</u>
WELL COMPLETION DATA: (1) diameter (inches) <u>4</u>	<u>White sand</u>	<u>100</u>	<u>135</u>
(2) total depth (feet) <u>141</u>			
(3) static water level (feet) <u>80</u> below top of ground.			
(4) casing <u>PVC</u> , <u>141</u> (material) (depth) If telescope see back. (size)			
(5) screen <u>4'</u> <u>141</u> (length) (depth to top) <u>4"</u> <u>Gravel type</u> (size) (material)			
(6) pump <u>1/2</u> <u>10</u> (HP) (yield gpm) <u>220V</u> (type power)			
(7) electric log <u>No</u> (yes or no)			
(8) how well bottom plugged <u>Cap</u>			
DRILLERS REMARKS:			

RECEIVED
 JUN 29 1978

MISS. BD. OF WATER COM.

If well telescopes please sketch and show depths.

GROUND LEVEL

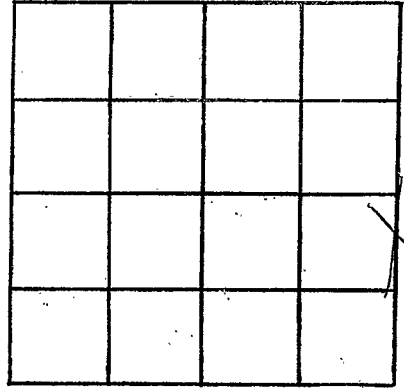

SECTION 6

Please indicate well location X.

ADDITIONAL INFORMATION

If more than one screen,
show locations of each on sketch.