

TATE
M 2008

MISSISSIPPI
BOARD OF WATER COMMISSIONERS
416 North State Street
Jackson, Mississippi 39201

WATER WELL DRILLERS LOG

7-14 1978 High Well Co Tate
date well completed firm name county well located

LANDOWNER	Description of formations encountered	from	to
Spring Hill Church			
Red clay		0	40
Red Sand + gravel		40	90
White Sand		90	120

LANDOWNER: Spring Hill Church
 (mailing address) Camoo, Mo.

WELL LOCATION:
 sec. 13 T. 6 N. R. 7 E. W. 5
1 miles W of Gravel Springs
 (distance) (direction) (nearest town)

WELL PURPOSE: Church
 (home, irrigation, municipal, industrial)

WELL COMPLETION DATA:

(1) diameter (inches) 4

(2) total depth (feet) 120

(3) static water level (feet) 88 below above top of ground.

(4) casing PVC, 120,
 (material) (depth)

(size) if telescope see back.

(5) screen 7', 113
 (length) (depth to top)

4", Gravel
 (size) (material)

(6) pump 1/2, 15
 (HP) (yield gpm)

220V
 (type power)

(7) electric log No
 (yes or no)

(organization running log)

(8) how well bottom plugged Cap

DRILLERS REMARKS:


RECEIVED

JUL 21 1978

MISS. BD. OF WATER COMM.

If well telescopes please sketch and show depths.

GROUND LEVEL

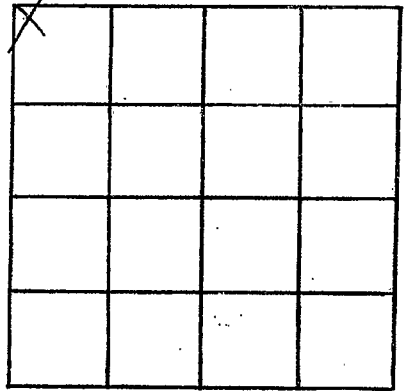

SECTION 13

Please indicate well location X.

ADDITIONAL INFORMATION

If more than one screen,
show locations of each on sketch.