


TATE
M 2009
5-22-78

MISSISSIPPI
BOARD OF WATER COMMISSIONERS
416 North State Street
Jackson, Mississippi 39201

WATER WELL DRILLERS LOG

5-22-78 19 Bob Smith Well Serv. Tate
 date well completed firm name county well located


LANDOWNER:	description of formations encountered	from	to
Sam Willerson Spartanburg, Mo. (mailing address)			
WELL LOCATION: sec. 5 T-8 N R-7 E 4 miles S of Spartanburg (distance) (direction) (nearest town)			
WELL PURPOSE: (home, irrigation, municipal, industrial)			
WELL COMPLETION DATA:			
(1) diameter (inches) 4"			
(2) total depth (feet) 160'			
(3) static water level (feet) 90 below top of ground			
(4) casing (material) plastic (depth) 160'			
(size) If telescope see back.			
(5) screen (length) 20 (depth to top) 140'			
(size) 3/4" (material) plastic			
(6) pump (HP) 3/4 (yield gpm) 10			
(type power) Elec.			
(7) electric log (yes or no) (no)			
(organization running log)			
(8) how well bottom plugged (plugged)			
DRILLERS REMARKS:			

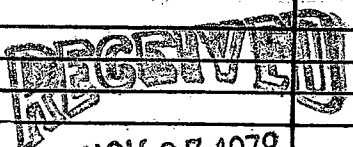

MISS. BD. OF WATER COMMISSIONERS

If well telescopes please sketch and show depths.

GROUND LEVEL

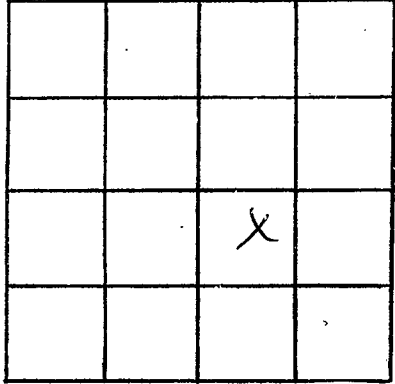

SECTION _____

Please indicate well location X.

ADDITIONAL INFORMATION

If more than one screen, show locations of each on sketch.