

TATE
M 2010
12-06-78

**MISSISSIPPI
BOARD OF WATER COMMISSIONERS**
416 North State Street
Jackson, Mississippi 39201

WATER WELL DRILLERS LOG

12-6-78 1978 Hicks Well Co Tate
 date well completed firm name county well located

LANDOWNER: J.W. Walker
Rt. 11
Senatobia, Ms.
 (mailing address)

description of formations encountered	from	to
<u>Red clay</u>	<u>0</u>	<u>10</u>
<u>Gravel</u>	<u>10</u>	<u>120</u>

WELL LOCATION:
 sec. 7 T. 6 N. R. 7 E
2 1/2 miles SW of Senatobia
 (distance) (direction) (nearest town)

<u>white sand</u>	<u>120</u>	<u>140</u>
-------------------	------------	------------

WELL PURPOSE: drinking
 (home, irrigation, municipal, industrial)

WELL COMPLETION DATA:

(1) diameter (inches) 4"

(2) total depth (feet) 140

(3) static water level (feet) 80 below above top of ground.

(4) casing PVC, 140,
 (material) (depth)
 (size) if telescope see back.

(5) screen 7', 133
 (length) (depth to top)
4", gravel type
 (size) (material)

(6) pump 1/2, 10
 (HP) (yield gpm)
220V
 (type power)

(7) electric log No
 (yes or no)

(organization running log)

(8) how well bottom plugged Cap


DRILLERS REMARKS:

RECEIVED
 DEC 11 1978

MISS. BD. OF WATER COMMISSIONERS

If well telescopes please sketch and show depths.

GROUND LEVEL

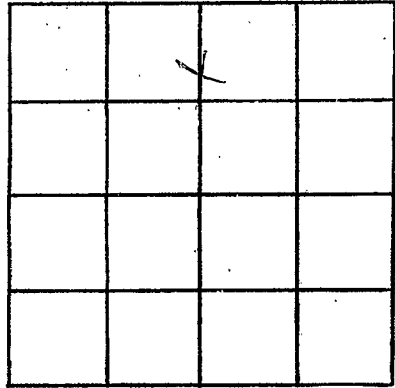

SECTION

7

Please indicate well location X.

ADDITIONAL INFORMATION

If more than one screen,
show locations of each on sketch.