

Tate
 Ma 2012
 10-12-79

MISSISSIPPI
 BOARD OF WATER COMMISSIONERS
 416 North State Street
 Jackson, Mississippi 39201

WATER WELL DRILLERS LOG

10-12 1979 Tate
 date well completed firm name county well located

LANDOWNER:
 Robert Thompson
 New Town
 (mailing address)

description of formations encountered	from	to
red clay	0	30
red sand	30	65
white sand	65	125

WELL LOCATION:
 sec. 3 T. 6 N. R. 2 E.
 1 miles S of New Town
 (distance) (direction) (nearest town)

WELL PURPOSE: home
 (home, irrigation, municipal, industrial)

- WELL COMPLETION DATA:
- (1) diameter (inches) 4 in
 - (2) total depth (feet) 125
 - (3) static water level (feet) _____ below above top of ground.
 - (4) casing Plastic 125
 (material) (depth)
 (size) if telescope see back.
 - (5) screen 7 ft 118
 (length) (depth to top)
4 in Gravel
 (size) (material)
 - (6) pump 1/2 20
 (HP) (yield gpm)
220
 (type power)
 - (7) electric log No
 (yes or no)
 (organization running log)
 - (8) how well bottom plugged cap

DRILLERS REMARKS:


DEPT. OF NATURAL RESOURCES
 BUREAU OF LAND & WATER RESOURCES

OCT 22 1979

RECEIVED

If well telescopes please sketch and show depths.

GROUND LEVEL

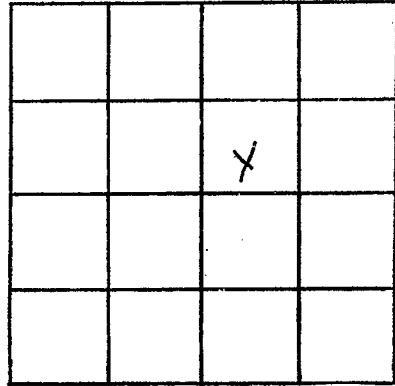

SECTION 3

Please indicate well location X.

ADDITIONAL INFORMATION

If more than one screen,
show locations of each on sketch.