

MISSISSIPPI
 BOARD OF WATER COMMISSIONERS
 416 North State Street
 Jackson, Mississippi 39201

WELL
 M 2013
 9-11-80
~~9/11/80~~
 9/11/80
 date well completed

WATER WELL DRILLERS LOG

Ed Smith Well Drilling Co.
 firm name
Itasca
 county well located

LANDOWNER:
William Clyde Pace
Como, Mo.
 (mailing address)

description of formations encountered	from	to
<i>top soil</i>	<i>0</i>	<i>5</i>
<i>shaly clay</i>	<i>5</i>	<i>60</i>
<i>red sand</i>	<i>60</i>	<i>80</i>
<i>white sand</i>	<i>80</i>	<i>185</i>

WELL LOCATION:
 sec. 13 T. 6 N. R. 7 E.
2 miles N of Como
 (distance) (direction) (nearest town)

WELL PURPOSE:
 (home, irrigation, municipal, industrial)

- WELL COMPLETION DATA:
- diameter (inches) 4 1/2
 - total depth (feet) 185
 - static water level (feet) 115 below above top of ground.
 - casing plastic 85
 (material) (depth)
 (size) if telescope see back.
 - screen 10' 185'
 (length) (depth to top)
4 1/2 plastic
 (size) (material)
 - pump 1/2 10
 (HP) (yield gpm)
elec.
 (type power)
 - electric log (yes or no)
 (organization running log)
 - how well bottom plugged cap

DEPT. OF NATURAL RESOURCES
 BUREAU OF LAND & WATER RESOURCES


OCT 15 1980

RECEIVED

DRILLERS REMARKS:

If well telescopes please sketch and show depths.

GROUND LEVEL

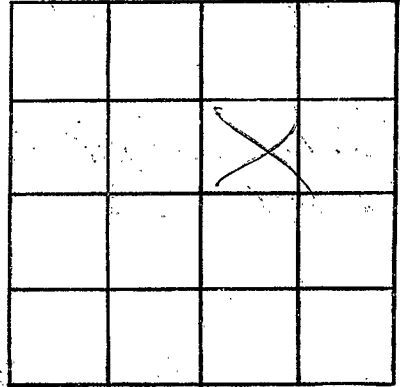

SECTION _____

Please indicate well location X.

ADDITIONAL INFORMATION

If more than one screen,
show locations of each on sketch.