

MISSISSIPPI DEPARTMENT OF NATURAL RESOURCES

Bureau of Land and Water Resources

Southport Mall

P.O. Box 10631

Jackson, Mississippi 39209

WATER WELL DRILLERS LOG

LATE
M 2014
C-15-81

6-15-81 date well completed Hicks' Well Co firm name Tate county well located

LANDOWNER: <u>Jerry Wooten</u>	description of formations encountered	from	to
<u>Senatobia, Mo.</u> (mailing address)			
	<u>Red sand</u>	<u>0</u>	<u>50</u>
	<u>white sand</u>	<u>50</u>	<u>125</u>

WELL LOCATION:
 sec. Q T 6 N 2 R 2 E W
2 miles S of New town
 (distance) (direction) (nearest town)

WELL PURPOSE: Home
 (home, irrigation, municipal, industrial)

WELL COMPLETION DATA:

(1) diameter (inches) 4

(2) total depth (feet) 125

(3) static water level (feet) 165 below above top of ground.

(4) casing PVC, 125
 (material) (depth)

3 If telescope see back.
 (size)

(5) screen 12, 123
 (length) (depth to top)

4", gravel type
 (size) (material)


(6) pump 1/2, 18
 (HP) (yield gpm)

220V
 (type power)

(7) electric log Yes
 (yes or no)

(organization running log)


(8) how well bottom plugged Cap

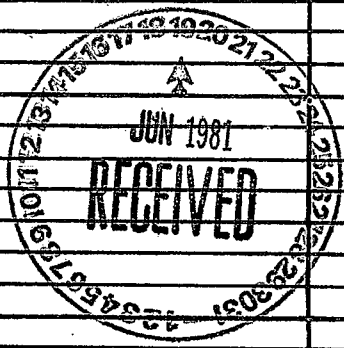

DRILLERS REMARKS:

If well telescopes please sketch and show depths.

GROUND LEVEL

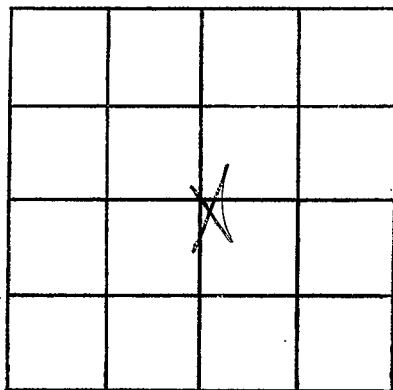

SECTION 2

Please indicate well location X.

ADDITIONAL INFORMATION

If more than one screen,
show locations of each on sketch.