


MISSISSIPPI DEPARTMENT OF NATURAL RESOURCES
Bureau of Land and Water Resources
 Southport Mall
 P.O. Box 10631
 Jackson, Mississippi 39209
WATER WELL DRILLERS LOG

Lata
M 205
7-14-87


7-14 1987 Hicks Well Co. Lata
 date well completed firm name county well located

LANDOWNER	description of formations encountered	from	to
<u>Johnny Lee Weble</u> <u>Rt. 3</u> <u>Coldwater, Mo.</u> (mailing address)	<u>Red Clay</u>	<u>0</u>	<u>10</u>
WELL LOCATION: sec. <u>2</u> T <u>6</u> N R <u>7</u> E <u>2</u> miles <u>S</u> of <u>Newtown</u> (distance) (direction) (nearest town)	<u>Red Sand</u>	<u>10</u>	<u>30</u>
WELL PURPOSE: <u>Home</u> (home, irrigation, municipal, industrial)	<u>Gravel</u>	<u>30</u>	<u>50</u>
WELL COMPLETION DATA: (1) diameter (inches) <u>4</u>	<u>White Sand</u>	<u>50</u>	<u>105</u>
(2) total depth (feet) <u>105</u>			
(3) static water level (feet) <u>65</u> below above top of ground.			
(4) casing <u>PVC</u> , <u>105</u> (material) (depth)			
- If telescope see back. (size)			
(5) screen <u>12'</u> , <u>93</u> (length) (depth to top)			
<u>4"</u> , <u>gravel + PVC</u> (size) (material)			
(6) pump <u>1/2</u> , <u>10</u> (HP) (yield gpm)			
<u>220V</u> (type power)			
(7) electric log <u>No</u> (yes or no)			
(organization running log)			
(8) how well bottom plugged <u>Cap</u>			
DRILLERS REMARKS:			

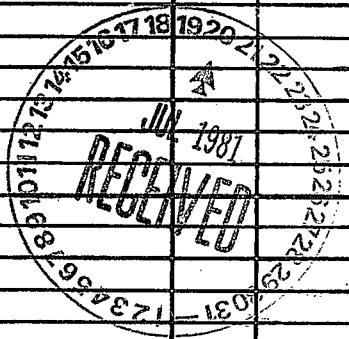

If well telescopes please sketch and show depths.

GROUND LEVEL

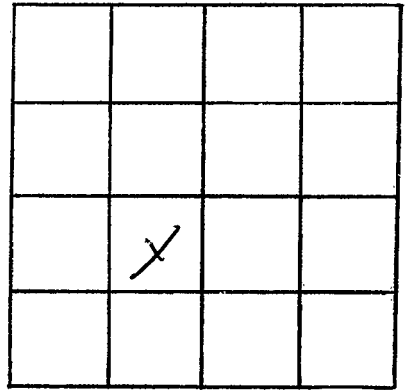

SECTION 2

Please indicate well location X.

ADDITIONAL INFORMATION

Lined area for additional information.

If more than one screen, show locations of each on sketch.