

MISSISSIPPI DEPARTMENT OF NATURAL RESOURCES

Bureau of Land and Water Resources

Southport Mall

P.O. Box 10631

Jackson, Mississippi 39209

WATER WELL DRILLERS LOG

HICKS WELL CO.

Pt. 1, Box 157

Senatobia, MS 38668

|         |
|---------|
| Date    |
| Ms 2046 |
| 8-28-81 |

8-28 19 81 date well completed      Tate county well located


| LANDOWNER                                                    | description of formations encountered | from       | to         |
|--------------------------------------------------------------|---------------------------------------|------------|------------|
| <u>Mrs. Robert W. Patterson</u>                              |                                       |            |            |
| <u>P.O. Box 192</u>                                          | <u>Red Clay</u>                       | <u>0</u>   | <u>20</u>  |
| <u>Conno, Ms. 38619</u><br>(mailing address)                 | <u>Red Sand</u>                       | <u>20</u>  | <u>35</u>  |
| <b>WELL LOCATION:</b>                                        | <u>Drum</u>                           | <u>35</u>  | <u>110</u> |
| sec. <u>8</u> T. <u>6</u> N. R. <u>7</u> E                   | <u>White Sand</u>                     | <u>110</u> | <u>150</u> |
| <u>2 1/2</u> miles <u>S</u> of <u>Senatobia</u>              |                                       |            |            |
| (distance) (direction) (nearest town)                        |                                       |            |            |
| <b>WELL PURPOSE:</b> <u>Home</u>                             |                                       |            |            |
| (home, irrigation, municipal, industrial)                    |                                       |            |            |
| <b>WELL COMPLETION DATA:</b>                                 |                                       |            |            |
| (1) diameter (inches) <u>4</u>                               |                                       |            |            |
| (2) total depth (feet) <u>150</u>                            |                                       |            |            |
| (3) static water level (feet) <u>80</u> below top of ground. |                                       |            |            |
| (4) casing <u>PVC</u> , <u>150</u><br>(material) (depth)     |                                       |            |            |
| <u>      </u> if telescope see back.<br>(size)               |                                       |            |            |
| (5) screen <u>7</u> , <u>143</u><br>(length) (depth to top)  |                                       |            |            |
| <u>4"</u> , <u>gravel type</u><br>(size) (material)          |                                       |            |            |
| (6) pump <u>1/2</u> , <u>10</u><br>(HP) (yield gpm)          |                                       |            |            |
| <u>220V</u><br>(type power)                                  |                                       |            |            |
| (7) electric log <u>No</u><br>(yes or no)                    |                                       |            |            |
| <u>      </u><br>(organization running log)                  |                                       |            |            |
| (8) how well bottom plugged <u>Cap</u>                       |                                       |            |            |
| <b>DRILLERS REMARKS:</b>                                     |                                       |            |            |

DEPT. OF NATURAL RESOURCES  
BUREAU OF LAND & WATER RESOURCES

SEP 24 1981  
RECEIVED

If well telescopes please sketch and show depths.

GROUND LEVEL

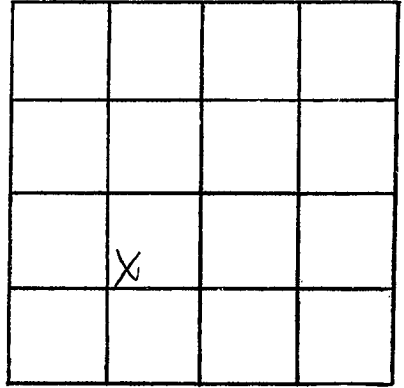

SECTION 8

Please indicate well location X.

ADDITIONAL INFORMATION

If more than one screen,  
show locations of each on sketch.