

MISSISSIPPI DEPARTMENT OF NATURAL RESOURCES

Bureau of Land and Water Resources

Southport Mall

P.O. Box 10631

Jackson, Mississippi 39209

WATER WELL DRILLERS LOG

HICKS WELL CO.

Pt. 1, Box 157

Senatobia, MS 38668

Tate

Date
M
2018

7-27 1982
date well completed

county well located

LANDOWNER	Description of formations encountered	from	to
<i>Herbert Whalen Farm</i>			
<i>106 Ward</i>			
<i>Senatobia, Miss.</i>	<i>Red Clay</i>	<i>0</i>	<i>10</i>
<i>(mailing address) 38668</i>	<i>Gravel & Sand</i>	<i>10</i>	<i>80</i>
WELL LOCATION:			
sec. <i>4</i> T. <i>6</i> N. R. <i>2</i> E.			
<i>1 1/2</i> miles <i>SE</i> of <i>Senatobia</i>			
(distance) (direction) (nearest town)			
WELL PURPOSE: <i>Farm</i>			
(home, irrigation, municipal, industrial)			
WELL COMPLETION DATA:			
(1) diameter (inches) <i>4</i>			
(2) total depth (feet) <i>80</i>			
(3) static water level (feet) <i>0</i> <input checked="" type="radio"/> below <input type="radio"/> above top of ground.			
(4) casing <i>PVC</i> , <i>80</i> , (material) (depth)			
<i>4"</i> if telescope see back. (size)			
(5) screen <i>15</i> , <i>65</i> (length) (depth to top)			
<i>0.10</i> , <i>PVC</i> (size) (material)			
(6) pump <i>1/2</i> , <i>10</i> (HP) (yield gpm)			
<i>220V</i> (type power)			
(7) electric log <i>No</i> (yes or no)			
(organization running log)			
(8) how well bottom plugged <i>Cap</i>			
DRILLERS REMARKS:			


DEPT. OF NATURAL RESOURCES
BUREAU OF LAND & WATER RESOURCES

AUG - 4 1982

RECEIVED

If well telescopes please sketch and show depths.

GROUND LEVEL

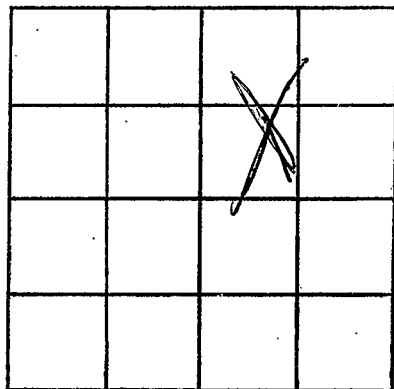

SECTION 4

Please indicate well location X.

ADDITIONAL INFORMATION

If more than one screen,
show locations of each on sketch.