

MISSISSIPPI DEPARTMENT OF NATURAL RESOURCES

Bureau of Land and Water Resources

Southport Mall

P.O. Box 10631

Jackson, Mississippi 39209

WATER WELL DRILLERS LOG

Date
M
209

12-20 1982

HICKS WELL CO.

Date

date well completed

RT. 1, HARRIS
 Senatobia, MS 38660

county well located

LANDOWNER: Mary Heagy
Ref. 3
Senatobia, Miss.
 (mailing address) 38660

description of formations encountered	from	to
<u>Red Clay</u>	<u>0</u>	<u>10</u>
<u>Red Sand & Gravel</u>	<u>10</u>	<u>50</u>
<u>white sand</u>	<u>50</u>	<u>155</u>

WELL LOCATION:
 sec. 1 T. 6 N. R. 7 E.
2 miles SE of New Town
 (distance) (direction) (nearest town)

WELL PURPOSE: Home
 (home, irrigation, municipal, industrial)

- WELL COMPLETION DATA:
- (1) diameter (inches) 4
 - (2) total depth (feet) 155
 - (3) static water level (feet) 100 below above top of ground.
 - (4) casing PVC, 155
 (material) (depth)
4" ~~4"~~ If telescope see back.
 (size)
 - (5) screen 15', 140
 (length) (depth to top)
013, PVC
 (size) (material)
 - (6) pump 1, 18
 (HP) (yield gpm)
220V
 (type power)
 - (7) electric log No
 (yes or no)
- (organization running log)
- (8) how well bottom plugged Cap

DRILLERS REMARKS:


DEPT. OF NATURAL RESOURCES
 BUREAU OF LAND & WATER RESOURCES

FEB 22 1983

RECEIVED

If well telescopes please sketch and show depths.

GROUND LEVEL

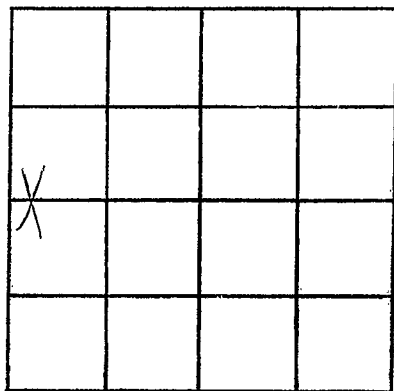

SECTION 1

Please indicate well location X.

ADDITIONAL INFORMATION

If more than one screen,
show locations of each on sketch.