

MISSISSIPPI DEPARTMENT OF NATURAL RESOURCES
Bureau of Land and Water Resources
 Southport Mall
 P.O. Box 10631
 Jackson, Mississippi 39209
WATER WELL DRILLERS LOG

Date
M
2020

3-9 1983
 date well completed

HICKS WELL CO.
 Rt. 1, Box 177
 Senatobia, MS 38669

Tate
 county well located


LANDOWNER:	description of formations encountered	from	to
<u>Linda Bell Collins</u>			
<u>P.O. Box 305</u>	<u>Red Clay</u>	<u>0</u>	<u>20</u>
<u>Senatobia, Miss. 38669</u> (mailing address)	<u>Red Sand</u>	<u>20</u>	<u>35</u>
WELL LOCATION:	<u>Clay + Sand</u>	<u>35</u>	<u>80</u>
sec. <u>12</u> T. <u>6</u> N. R. <u>7</u> E. W. <u>3</u>	<u>Gravel</u>	<u>80</u>	<u>110</u>
<u>1</u> miles <u>W</u> of <u>Springfield</u> (distance) (direction) (nearest town)	<u>White Sand</u>	<u>110</u>	<u>160</u>
WELL PURPOSE: <u>Home</u> (home, irrigation, municipal, industrial)			
WELL COMPLETION DATA:			
(1) diameter (inches) <u>4</u>			
(2) total depth (feet) <u>160</u>			
(3) static water level (feet) <u>80</u> <u>below</u> above top of ground.			
(4) casing <u>PVC, 160,</u> (material) (depth)			
<u>4"</u> (size) if telescope see back.			
(5) screen <u>10'</u> <u>150'</u> (length) (depth to top)			
<u>.015,</u> <u>PVC</u> (size) (material)			
(6) pump <u>1/2</u> <u>10</u> (HP) (yield gpm)			
<u>22.0V</u> (type power)			
(7) electric log <u>No</u> (yes or no)			
(organization running log)			
(8) how well bottom plugged <u>Cap</u>			
DRILLERS REMARKS:			

DEPT. OF NATURAL RESOURCES
 BUREAU OF LAND & WATER RESOURCES

MAR 28 1983
 RECEIVED

If well telescopes please sketch and show depths.

GROUND LEVEL

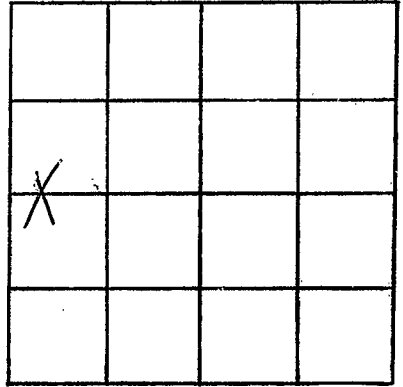

SECTION 12

Please indicate well location X.

ADDITIONAL INFORMATION

If more than one screen,
show locations of each on sketch.